

# MISSISSIPPI DEPARTMENT OF ENVIRONMENTAL QUALITY

Office of Land and Water Resources

P. O. Box 10631  
Jackson, MS 39289-0631

## WATER WELL DRILLERS LOG

COUNTY WELL LOCATED <i>Sharkey</i>	
WELL NUMBER <i>F 2011</i>	CODED
DATE WELL COMPLETED <i>1-17-96</i>	

PERMIT NUMBER
NAME OF DRILLING FIRM <i>Schudco Ltd</i>

NAME & MAILING ADDRESS OF LANDOWNER <i>Mississippi Department of Wildlife, Fisheries and Parks Twin Oaks Route 1, Box 15 Anquilla, MS, 38721</i>		
WELL LOCATION: SEC	TOWNSHIP	RANGE
<i>32</i>	<i>12</i>	<i>N 6 E</i>
DISTANCE	DIRECTION	NEAREST TOWN
<i>4</i> Miles	<i>SE</i>	<i>Rollingfork</i>
OTHER LANDMARK		
WELL PURPOSE ( <u>Home</u> ) Irrigation, Municipal, Industrial, Fish Pond, etc.		


PUMP DATA		
PUMP TYPE (Circle One): <u>Submersible</u> Turbine, Jet, Flowing Well, Other (Describe) _____		
POWER TYPE (Circle One): <u>Electric</u> Tractor, Diesel, Gasoline, Butane, Other (Describe) _____ H/P <u>1</u>		
Pump Capacity (GPM) <i>18</i>	No. of Stages <i>7</i>	Setting Depth <i>40</i> FT.
PUMP TEST		
Well yielded _____ GPM with a drawdown of _____ ft. after _____ hours of pumping		

WELL DATA		
Well Depth <i>80</i>	Casing Diameter (In.) <i>4 in</i>	Casing Length (Ft.) <i>70</i>
Type of Casing <i>pvc</i>	Hole Depth <i>80 ft</i>	Depth to Static Water Level <i>17 ft</i>
TYPE OF COMPLETION: (Circle One or More): <u>Gravel Packed</u> Underreamed, Telescoped, Natural Development, Open Hole, Other (Describe) _____		
WELL GROUTED TO A DEPTH OF <u>10</u> FEET Type Grout (circle one) <u>Cement</u> Bentonite, or Mix		

LOG DATA	
TYPE OF LOG RUN (Circle One): <u>No Log Run</u> Electric, Gamma Ray, Density, Sonic, Neutron, Other (Describe) _____	
Name of Organization Running Log	

SCREEN DATA		
Diameter - Inches <i>3</i>	Length - Feet <i>10</i>	Slot Size - Inches <i>1010</i>
Screen Type <i>pvc</i>		Depth to Bottom - Feet <i>80</i>

GEOLOGIC DATA (Office Use Only)			
Surface Elev.	Geologic Unit	Unit Thickness	Depth to Top
Subs. SWL	Date	Analysis	Aquifer Test
Driller's Remarks			

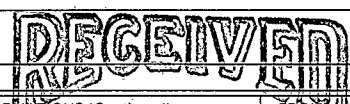

DESCRIPTION OF FORMATIONS ENCOUNTERED	FROM	TO	FORMATIONS (Continued)	
			FROM	TO
<i>clay</i>	<i>0</i>	<i>12</i>		
<i>sand</i>	<i>12</i>	<i>16</i>		
<i>clay</i>	<i>16</i>	<i>45</i>		
<i>sand</i>	<i>45</i>	<i>80</i>		

JAN 23 1996

Dept. of Environmental Quality  
Office of Land & Water Resources

IF MORE SPACE IS NEEDED, USE BACK

If well telescopes please sketch and show depths.

GROUND LEVEL

X			

SECTION 32

Please indicate well location X.

ADDITIONAL INFORMATION

If more than one screen,  
show location of each on sketch.