

SHARKEY
G-12
8-13-71

MISSISSIPPI
 BOARD OF WATER COMMISSIONERS
 416 North State Street
 Jackson, Mississippi 39201

CODED
 C13790-3440

WATER WELL DRILLERS LOG

August 13, 1971 SINGER-Layne Central Division Sharkey
 date well completed firm name county well located

LANDOWNER: Joe Priddy & Sons	description of formations encountered	from	to
Cary, Mississippi			
	Coarse sand	35	50
	Coarse sand, pea gravel	50	90
(mailing address)	Coarse sand, big gravel	90	112

WELL LOCATION:
 sec. 9 T. 11 N R. 7 ~~xE~~ W
 6 miles SE of Cary
 (distance) (direction) (nearest town)

WELL PURPOSE: irrigation
 (home, irrigation, municipal, industrial)

- WELL COMPLETION DATA:**
- (1) diameter (inches) 16
 - (2) total depth (feet) 112
 - (3) static water level (feet) 10' 10" below top of ground. ~~10' 10" above~~
 - (4) casing steel 62' (material), (depth)
 16" (size) if telescope see back.
 - (5) screen 50' (length), 62' (depth to top)
 16" (size), Armco (material)
 - (6) pump 60 (HP) 2500 (yield gpm)
 electric (type power)
 - (7) electric log no (yes or no)
 (organization running log)
 - (8) how well bottom plugged plate

CODED


SEP 13 1971

MISS. BD. OF
 WATER COMM.

DRILLERS REMARKS:

well telescopes please
etch and show depths.

GROUND LEVEL

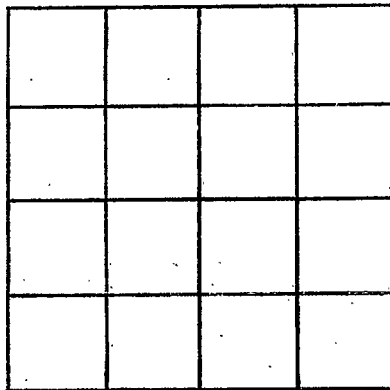

SECTION _____

Please indicate well location X.

ADDITIONAL INFORMATION

If more than one screen,
show locations of each on sketch.