

SHARKEY MISSISSIPPI BOARD OF WATER COMMISSIONERS

G13

8-5-65

CODED

WATER WELL DRILLERS LOG

Sharkey

Date: 8-5, 1965, Driller: David Beatty County: Sharkey

Log # 51

(1) Owner of Land: Belgrade Lumber Co.  
(Name)  
Cony, Miss  
(Address)

(2) Location: NW 1/4, Sec. 16 T11R2W  
(distance) \_\_\_\_\_ miles (direction) \_\_\_\_\_ of Cony (Nearest Town)

(3) Topography: Flat  
(Hilly) (Flat) (Level)

(4) Purpose of Well: Industrial  
(Domestic Irrigation Municipal, Industrial, Other)

Description & Color of Materials Sand, Clay, Red Clay, Shell, etc.	Thick-ness Feet	Depth Feet
Surface	34	34
Sand	10	44
Sand	31.6	75.6
Sand	27.7	103.1
pes. gravel	30.6	133.7
pes. gravel	31.2	164.9
Clay	30.3	197
Clay (stuck) sand	30.3	227.3
Clay (stuck) sand	30.6	257.9
shale	30.2	288.1
sand bread clay	30.10	318.9
sand	34.1	349.10
sand	31	380.10
sand	30	410.10
sand & clay	30.1	440.11
shale	29.10	469.21
shale	29.4	498.61
shale	30.11	528.72
shale (stuck) sand	21.9	550.62
shale (stuck) sand	21.8	572.42
shale (stuck) sand	4.3	576.72
hard shale	21.9	598.62
hard shale	21.9	620.52
shale	21.10	641.62
shale	20.4	662.02
shale	21.9	683.92
shale (stuck) sand	20.9	704.82
sand	11.8	716.62
sandy shale	30.10	746.72
sandy shale	18.8	765.52
sandy shale	27	792.52
sandy shale	30.9	823.42

Information upon completion of well:

(1) Diameter 4 1/2 inches.

(2) Total Depth 976 feet.

(3) Water Level Top of gravel feet below top of ground. 169 of 4"

(4) Cased to 936, Size 2 1/2 of 2 1/2


(5) Screen: Size 2 1/2, Length 40 ft.

(6) Were any formations sealed against pollution?  
 \_\_\_\_\_ yes, \_\_\_\_\_ no.

If YES depth of formation \_\_\_\_\_

Why \_\_\_\_\_

Drillers Remarks: \_\_\_\_\_

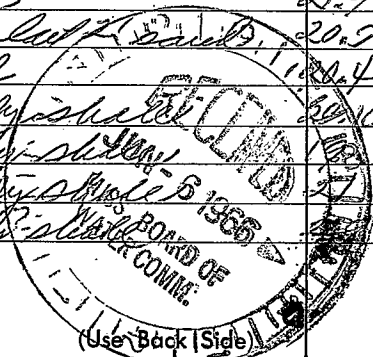

Well No.

# St. Brandon

830	20.2	Share
852.9	20.9	Share
872.8	21.11	Share last 10% share
892.5	19.9	Share, stock, bank
913.1	20.8	Share last 10% share
933.6	20.5	Share
953.11	20.5	Sharely share
974.8	20.9	Share
976	2.4	Share