

Sharkey
G 15
3-64

OK 7/29/69

WATER WELL DRILLERS LOG

CODED

Date: March, 1964, Driller: David Benny County: Sharkey
(Name)

(1) Owner of Land: Jack D'Amato
(Name)
Cany, Miss.
(Address)
3 11-7
(2) Location: 3/5 11-7
5 1/4 Sec. T R
_____ miles _____ of _____
(distance) (direction) (Nearest Town)
(3) Topography: flat
(Hilly) (Flat) (Level)
(4) Purpose of Well: Domestic
(Domestic Irrigation
Municipal, Industrial, Other)


Description & Color of Materials Sand, Clay, Red Clay, Shell, etc.	Thick- ness Feet	Depth Feet
<u>Kelly</u>	<u>39</u>	<u>39</u>
<u>Clay & sand</u>	<u>30</u>	<u>69</u>
<u>fine sand</u>	<u>20</u>	<u>89</u>
<u>sand & top of gravel</u>	<u>30</u>	<u>129</u>
<u>gravel</u>	<u>120</u>	<u>249</u>
<u>Clay</u>	<u>42</u>	<u>290</u>
<u>sand</u>	<u>69</u>	<u>359</u>
<u>Clay sub. of sand</u>	<u>10</u>	<u>369</u>
<u>sand with clay sub.</u>	<u>61</u>	<u>430</u>
<u>Clay</u>	<u>45</u>	<u>475</u>
<u>Hard brown of rock</u>	<u>15</u>	<u>490</u>
<u>sand, clay</u>	<u>15</u>	<u>505</u>
<u>broken layers of rock</u>	<u>15</u>	<u>520</u>
<u>sand with clay sub.</u>	<u>30</u>	<u>550</u>
<u>sandy clay</u>	<u>30</u>	<u>580</u>
<u>clay</u>	<u>30</u>	<u>610</u>
<u>clay</u>	<u>23</u>	<u>633</u>
<u>clay 10% sand</u>	<u>22</u>	<u>655</u>
<u>sand fine</u>	<u>21</u>	<u>676</u>
<u>sand fine</u>	<u>21</u>	<u>697</u>
<u>sand good</u>	<u>60</u>	<u>757</u>
<u>sand now out</u>	<u>20</u>	<u>777</u>
<u>Brown clay</u>	<u>22</u>	<u>799</u>
<u>brown hard clay</u>	<u>20</u>	<u>819</u>
<u>Brown hard clay</u>	<u>22</u>	<u>841</u>
<u>sand good</u>	<u>21</u>	<u>862</u>
<u>sand good</u>	<u>20</u>	<u>882</u>
<u>sand good</u>	<u>20</u>	<u>902</u>
<u>sand good</u>	<u>17</u>	<u>919</u>
<u>Clay</u>	<u>5</u>	<u>924</u>

Information upon completion of well:

(1) Diameter 4 1/2 inches.
(2) Total Depth 924 feet.
(3) Water Level 5 1/2 feet below top of ground. 203' of 4"
(4) Cased to 673' of 2" Size _____
(5) Screen: Size 2", Length 50%.
(6) Were any formations sealed against pollution?
_____ yes, _____ no.

If YES depth of formation _____
Why _____

Drillers Remarks: _____

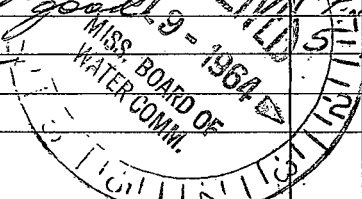

(Use Back Side)

Well No.

