

Sharkey  
G 24  
9-67

MISSISSIPPI  
BOARD OF WATER COMMISSIONERS  
416 North State Street  
Jackson, Mississippi 39201

CODED 10/4/67  
2527

WATER WELL DRILLERS LOG


September 21, 1967 Layne-Central Company Sharkey  
date well completed firm name county well located

| LANDOWNER: Darden Company                             | description of formations encountered |  | from | to  |
|---|---------------------------------------|--|------|-----|
|   | Top soil                              |  | 0    | 10  |
|   | Blue clay                             |  | 10   | 20  |
| Cary, Mississippi                                     | Fine sand                             |  | 20   | 40  |
| (mailing address)                                     | Coarse sand                           |  | 40   | 90  |
| WELL LOCATION:  | Fea gravel & sand                     |  | 90   | 160 |
| sec. 32 T. 11 N R. 7 E                                | Clay & lignite                        |  | 160  | 190 |
| S W   | Sandy clay                            |  | 190  | 225 |
| 4 miles south of Cary                                 | Hard sandy clay & shell               |  | 225  | 260 |
| (distance) (direction) (nearest town)                 | Fine green sand                       |  | 260  | 291 |
| WELL PURPOSE: home                                    | Rock                                  |  | 291  | 292 |
| (home, irrigation, municipal, industrial)             | Sandy shale                           |  | 292  | 390 |
| WELL COMPLETION DATA:                                 | Rock                                  |  | 390  | 391 |
| (1) diameter (inches) 4x3                             | Sandy shale                           |  | 391  | 420 |
| (2) total depth (feet) 1066' 4"                       | Rock                                  |  | 420  | 421 |
| (3) static water level (feet) 4' below top of ground. | Sandy clay                            |  | 421  | 471 |
| (4) casing steel 105' 11" of 4"                       | Fine sandy clay                       |  | 471  | 540 |
| (material) (depth) of 4"                              | Sand & lignite, sand                  |  |      |     |
| steel 922' 8" of 3"                                   | strks.                                |  | 540  | 555 |
| 4x3 (size) if telescope see back.                     | Rock                                  |  | 555  | 557 |
| (5) screen 30' 1058' 5"                               | Sandy clay & shell                    |  | 557  | 578 |
| (length) (depth to top)                               | Rock                                  |  | 558  | 579 |
| 3" Stainless Steel                                    | Sand & shell                          |  | 579  | 588 |
| (size) (material)                                     | Rock                                  |  | 588  | 590 |
| (6) pump _____ (HP) _____ (yield gpm)                 | Fine sand & shell                     |  | 590  | 600 |
| Unknown - Purchaser furnishes.                        | Rock                                  |  | 600  | 602 |
| (type power)  | Sand & 2 to 3 inch rock               |  |      |     |
| (7) electric log no                                   | strks.                                |  | 602  | 628 |
| (yes or no)   | Rock & shell                          |  | 628  | 630 |
| (organization running log)                            | Clay & shell                          |  | 630  | 668 |
| (8) how well bottom plugged 75 lbs shot               | Sandy clay                            |  | 668  | 685 |
|   | Rock                                  |  | 685  | 686 |
| DRILLERS REMARKS:                                     | Sandy clay                            |  | 686  | 701 |
|   | Rock                                  |  | 701  | 702 |
|   | Clay & shell                          |  | 702  | 715 |
|   | Rock                                  |  | 715  | 716 |
|   | Clay & shell                          |  | 716  | 755 |
|   | Rock                                  |  | 755  | 759 |
|   | Clay & shell                          |  | 759  | 786 |
|   | Sand & clay strks.                    |  | 786  | 819 |
|   | Clay                                  |  | 819  | 885 |

(over)

If well telescopes please sketch and show depths.

GROUND LEVEL

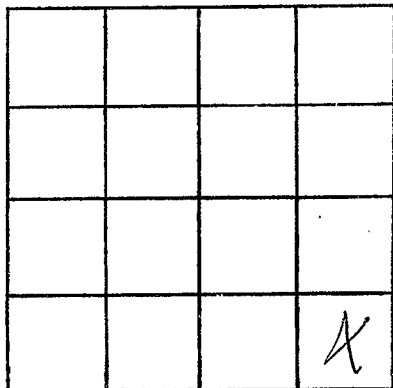

SECTION 32

Please indicate well location X.

ADDITIONAL INFORMATION

|                       |            |
|-----------------------|------------|
| Hard sandy shell      | 885 - 918  |
| Rock                  | 918 - 921  |
| Clay with sand strks. | 921 - 983  |
| Fine sand             | 983 - 1066 |

If more than one screen, show locations of each on sketch.