

SHARKEY

Q 25

10-20-75

MISSISSIPPI BOARD OF WATER COMMISSIONERS

155 416 North State Street
Jackson, Mississippi 39201.

CODED

WATER WELL DRILLERS LOG

CODED

OCT. 20

19 75 Dyet-Sullivan

SHARKEY

date well completed

firm name

county well located

LANDOWNER: DONALD HARRISON
CAREY, MISS.

description of formations encountered

from

to

| | | |
|---------------|----|-----|
| CLAY | 0 | 27 |
| FINE SAND | 27 | 36 |
| SAND & GRAVEL | 36 | 113 |

(mailing address)

WELL LOCATION:

sec. 8 T. 11 N R. 7 E
2 miles N of CAREY
(distance) (direction) (nearest town)
elev. 103

WELL PURPOSE: IRRIGATION
(home, irrigation, municipal, industrial)

WELL COMPLETION DATA:

- (1) diameter (inches) 10"
- (2) total depth (feet) 113'
- (3) static water level (feet) 11' below top of ground.
- (4) casing BIK. WST. 73' (material) (depth)
10" (size) if telescope see back.
- (5) screen 40' (length) 73' (depth to top)
12 (size) Doel-Gravel Guard (material)
- (6) pump 40 (HP) 1800 (yield gpm)
Diesel (type power)
- (7) electric log NO (yes or no)
- (8) how well bottom plugged PLATE


CODED

DRILLERS REMARKS:

DEC 22 1975

If well telescopes please sketch and show depths.

GROUND LEVEL

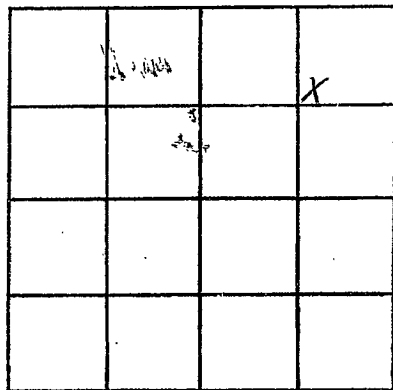

SECTION _____

Please indicate well location X.

ADDITIONAL INFORMATION

If more than one screen, show locations of each on sketch.