

SHARKEY
G 26
10-23-75

MISSISSIPPI
BOARD OF WATER COMMISSIONERS
416 North State Street
Jackson, Mississippi 39201

CODED

WATER WELL DRILLERS LOG

1975 OCT. 23 date well completed
Dyer-Sullivan firm name
SHARKEY county well located

LANDOWNER: DONALD HARRISON
CATEY, MISSI

(mailing address)

WELL LOCATION:
sec. 7 T 11 N R 7 E
2 1/2 miles W of CATEY
(distance) (direction) (nearest town)


WELL PURPOSE: 19919A702
(home, irrigation, municipal, industrial)

- WELL COMPLETION DATA:
- (1) diameter (inches) 16'
 - (2) total depth (feet) 113'
 - (3) static water level (feet) 11' below top of ground
 - (4) casing BKWMSST (material), 73' (depth)
16' (size) if telescope see back.
 - (5) screen 40' (length), 73' (depth to top)
16 (size), Dark Gravel (material)
 - (6) pump 50 (HP), 2500 (yield gpm)
Diesel (type power)
 - (7) electric log NO (yes or no)
- (organization running log)
- (8) how well bottom plugged PLATE

description of formations encountered	from	to
CLAY	0	54
Fine SAND	54	70
SAND & GRAVEL	70	113
elev. 103		
CODED		
DRILLERS REMARKS		
OCT. 22 1975		
WATER COMM		

If well telescopes please sketch and show depths.

GROUND LEVEL

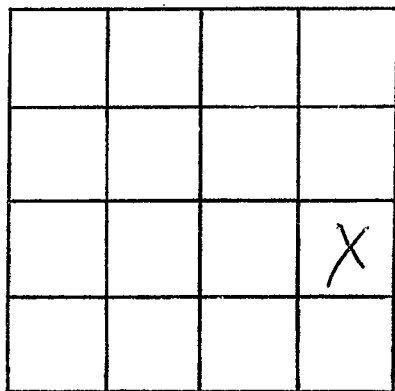

SECTION _____

Please indicate well location X.

ADDITIONAL INFORMATION

If more than one screen,
show locations of each on sketch.