

SHARKEY
G 27'
1-25-76
Flog #83
JAN. 23, 1976

MISSISSIPPI
 BOARD OF WATER COMMISSIONERS
 416 North State Street
 Jackson, Mississippi 39201

CODED

WATER WELL DRILLERS LOG

E.M. "Bud" CRESSWELL **SHARKEY**
 firm name county well located

LANDOWNER:
DARREL SMITH
Rollingfork, Ms.
 (mailing address)

WELL LOCATION:
 sec. 28 T. 11 N R. 7 E
1 miles S of CARY
 (distance) (direction) (nearest town)

description of formations encountered	from	to
Clay	0	25
Sand gravel	25	140
Sandy shale	140	320
Sand	320	460
Shale	460	680
Sandy shale	680	900
Sand	900	980

WELL PURPOSE: FARM
 (home, irrigation, municipal, industrial)

WELL COMPLETION DATA:

(1) diameter (inches) 4

(2) total depth (feet) 980

(3) static water level (feet) 6 below above top of ground.

(4) casing Steel, 940,
 (material) (depth)
4 if telescope see back.
 (size)

(5) screen 40, 940
 (length) (depth to top)
2, STAINLESS
 (size) (material)

(6) pump 1 1/2, 30
 (HP) (yield gpm)
0
 (type power)

(7) electric log yes
 (yes or no)
State
 (organization running log)

(8) how well bottom plugged
plug plug

CODED


RECEIVED

FEB 24 1976

DRILLERS REMARKS:

If well telescopes please sketch and show depths.

GROUND LEVEL

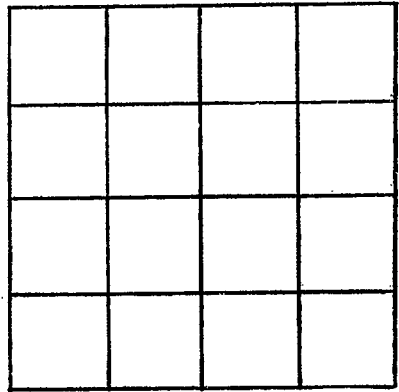

SECTION _____

Please indicate well location X.

ADDITIONAL INFORMATION

If more than one screen, show locations of each on sketch.