

Sharkey

MISSISSIPPI BOARD OF WATER COMMISSIONERS
416 North State Street
Jackson, Mississippi 39201

~~ISSUED~~
G29
8-28-76
Flag # 89

WATER WELL DRILLERS LOG

Sharkey

8-28-1976 date well completed
Gipcoat Drilling Co firm name
Harrison county well located

LANDOWNER: William Klaus

description of formations encountered

Evans plantation
Cory Miss (mailing address)

description of formations encountered	from	to
Clay	0	30
sand	30	97
gravel	97	140
Clay	140	158
sand	158	434
shale with shells	434	457
sandy shale	457	528
shale	528	670
sand with shells	670	723
shale	723	780
sand	780	858
		TD

WELL LOCATION:

sec. 17 T. 11 N. R. 7 W.
3/4 miles South of Cory (distance) (direction) (nearest town)

WELL PURPOSE: home (home, irrigation, municipal, industrial)

WELL COMPLETION DATA:

- (1) diameter (inches) 4 X 2 1/2
- (2) total depth (feet) 851
- (3) static water level (feet) 21 below top of ground.
- (4) casing (material) steel (depth) 815
- (5) screen (size) 4x2 (length) 30ft (depth to top) 815
- (6) pump (HP) 3 (yield gpm) 45
- (7) electric log (yes or no) yes (organization running log) M.S.B.
- (8) how well bottom plugged Steel plug

NEEDED


RECEIVED
SEP - 1 1976

MISS. BD. OF WATER COMMISSIONERS

DRILLERS REMARKS:

If well telescopes please sketch and show depths.

GROUND LEVEL

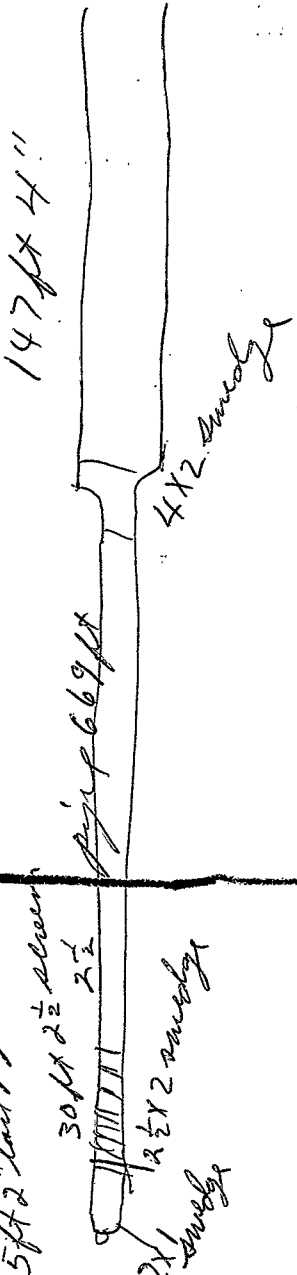

SECTION _____

Please indicate well location X.

ADDITIONAL INFORMATION

If more than one screen, show locations of each on sketch.