

SHARKEY
LS 30
SHARKEY
3-17-77

MISSISSIPPI
 BOARD OF WATER COMMISSIONERS
 416 North State Street
 Jackson, Mississippi 39201

CODED

WATER WELL DRILLERS LOG

MARCH 17 1977 E.M. "Bud" CRESSWELL SHARKEY
 date well completed firm name county well located

LANDOWNER:
 Moore Planting Co.
 Cary, Ms.
 (mailing address)

description of formations encountered	from	to
clay	0	25
sand & gravel	25	165
sand	165	430
Dark Phalo	430	820
sand	820	860

WELL LOCATION:
 sec. 20 T 11 N R. 7 E
 5 miles of Cary
 (distance) (direction) (nearest town)

WELL PURPOSE: FARM
 (home, irrigation, municipal, industrial)

- WELL COMPLETION DATA:
- (1) diameter (inches) 4
 - (2) total depth (feet) 860
 - (3) static water level (feet) 6 below top of ground.
 - (4) casing Steel, 820 (material) (depth)
 4 (size) if telescope see back.
 - (5) screen 40, 820 (length) (depth to top)
 2, Stainless (size) (material)
 - (6) pump 3 (HP) 75 (yield gpm)
 0 (type power)
 - (7) electric log Yes (yes or no)
 Arkle (organization running log)

CODED

(8) how well bottom plugged
 Steel plug


DRILLERS REMARKS:

RECEIVED
 APR 12 1977

MISS. BU. OF WATER COMMISSIONERS

If well telescopes please sketch and show depths.

GROUND LEVEL

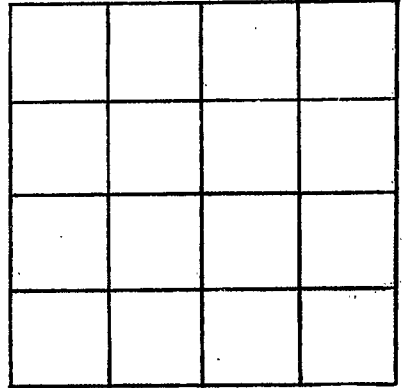

SECTION _____

Please indicate well location X.

ADDITIONAL INFORMATION

If more than one screen,
show locations of each on sketch.