

MISSISSIPPI  
 BOARD OF WATER COMMISSIONERS  
 416 North State Street  
 Jackson, Mississippi 39201

CODED

WATER WELL DRILLERS LOG

9-15 1977 Dyer Well + Irrigation Sharkey  
 date well completed firm name county well located

LANDOWNER: Donald Harris

Carey, Miss.

(mailing address)

description of formations encountered

from

to

Clay	0	28
Fine Sand	28	43
SAND + Gravel	43	113

WELL LOCATION:

sec 24 T 11 (N) R 7 E  
 S (W)  
3 miles E of Carey  
 (distance) (direction) (nearest town)

WELL PURPOSE: Irrigation  
 (home, irrigation, municipal, industrial)

CODED

WELL COMPLETION DATA:

- (1) diameter (inches) 16"
- (2) total depth (feet) 113'
- (3) static water level (feet) 18' below top of ground.
- (4) casing Steel, 73'  
 (material) (depth)  
16" if telescope see back.  
 (size)
- (5) screen 40', 73'  
 (length) (depth to top)  
16", Steel  
 (size) (material)
- (6) pump 100 2500  
 (HP) (yield gpm)  
Diesel  
 (type power)
- (7) electric log No  
 (yes or no)  
 (organization running log)
- (8) how well bottom plugged Plate


RECEIVED  
 MISSISSIPPI  
 SEP 20 1977

MISS. BD. OF WATER COMMISSIONERS

DRILLERS REMARKS:

If well telescopes please sketch and show depths.

GROUND LEVEL

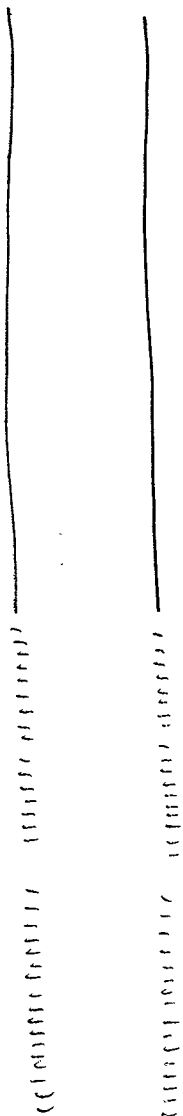

73' - 16"  
Casing

40' - 16"  
Screen - 2  
20' sections

X			

SECTION 24

Please indicate well location X.

ADDITIONAL INFORMATION

If more than one screen,  
show locations of each on sketch.