

SHARKEY  
 B34  
 11/7/78

MISSISSIPPI  
 BOARD OF WATER COMMISSIONERS  
 416 North State Street  
 Jackson, Mississippi 39201

CODED

WATER WELL DRILLERS LOG

No. 7 1978 E. M. "Bud" Coleswell Sharkey  
 date well completed firm name county well located


LANDOWNER:	description of formations encountered	from	to
W. W. Moore Cary, Ms. (mailing address)			
WELL LOCATION: sec. 28 T 11 N R 7 E 2 miles South of Cary, MS (distance) (direction) (nearest town)			CODED
WELL PURPOSE: farm (home, irrigation, municipal, industrial)			
WELL COMPLETION DATA:			
(1) diameter (inches) 4			
(2) total depth (feet) 120			
(3) static water level (feet) 18 below top of ground.			
(4) casing PVC 80 (material) (depth) 4 (size) if telescope see back.			
(5) screen 40 80 (length) (depth to top) 4 PVC (size) (material)			
(6) pump 2 50 (HP) (yield gpm) 0 (type power)			
(7) electric log No (yes or no)			
(organization running log)			
(8) how well bottom plugged steel plug			
DRILLERS REMARKS:			

RECEIVED  
 DEC - 5 1978

MISS. BD. OF WATER COMMISSIONERS

If well telescopes please sketch and show depths.

GROUND LEVEL

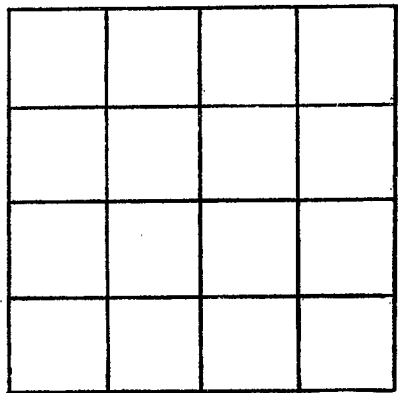

SECTION \_\_\_\_\_

Please indicate well location X.

ADDITIONAL INFORMATION

A series of horizontal lines for recording additional information, starting below the 'ADDITIONAL INFORMATION' header and extending to the bottom of the page.

If more than one screen, show locations of each on sketch.