

SHARKEY
 540
 6-20-81
 E log # 108

MISSISSIPPI
 BOARD OF WATER COMMISSIONERS
 416 North State Street
 Jackson, Mississippi 39201

COPIED

WATER WELL DRILLERS LOG

MAR 15 1982

6-20-81 1981 date well completed
 Jettcraft Drilling Co. firm name
 Sharkey county well to cite

RECEIVED

LANDOWNER:
 Mr. Ben Damensdorf
 Rolling Fork, MS.
 (mailing address)

description of formations encountered	from	to
Clay	0	30
Sand	30	86
Gravel	86	120
Sand	120	220
Shale	220	280
Sand	280	405
Shale	405	640
Sand	640	664
Shale	664	685
Sand	685	735
Shale	735	860
Sand	860	950
		T.D.

WELL LOCATION:
 sec. 3 T 11 N R 7 E
 NW/4 S SW/4 W of Rolling Fork
 (distance) miles (direction) of (nearest town)

WELL PURPOSE:
 (home, irrigation, municipal, industrial)


- WELL COMPLETION DATA:
- diameter (inches) 4"
 - total depth (feet) 950
 - static water level (feet) 23 below top of ground.
 - casing Steel, 850 (material), (depth)
 3" (size) if telescope see back.
 - screen 40' (length), 9'10" (depth to top)
 3" (size), stainless steel (material)
 - pump 5 (HP), 85 (yield gpm)
 AC. (type power)
 - electric log Yes (yes or no)
 Bureau of Geology (organization running log)
 - how well bottom plugged Backwash

COPIED

DRILLERS REMARKS:

If well telescopes please sketch and show depths.

GROUND LEVEL

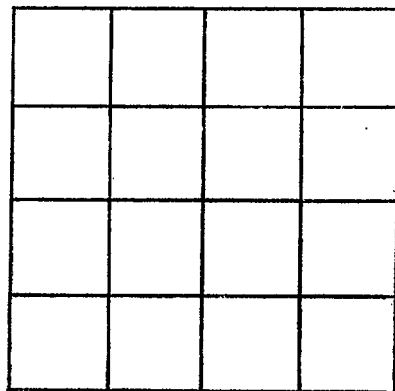

SECTION _____

Please indicate well location X.

ADDITIONAL INFORMATION

If more than one screen, show locations of each on sketch.