

Sharkey

G 45

3-2-81

MISSISSIPPI
BOARD OF WATER COMMISSIONERS
416 North State Street
Jackson, Mississippi 39201

CODED

WATER WELL DRILLERS LOG

MAC 2
date well completed

19

Well # 3

firm name

Sharkey

county well located

LANDOWNER: Stewart

P. O. Box 248

Cary, MS 30954
(mailing address)

WELL LOCATION:

sec. 5 T. 11 N R. 7 E
S W
3 miles E. of Cary
(distance) (direction) (nearest town)

WELL PURPOSE: Irrigation
(home, irrigation, municipal, industrial)

WELL COMPLETION DATA:

- (1) diameter (inches) 16"
(2) total depth (feet) 114'
(3) static water level (feet) 12' below top of ground.
(4) casing steel 74' (material) (depth) 16" (size) if telescope see back.
(5) screen 40' 74' (length) (depth to top) 16" steel (size) (material)
(6) pump 65 3800 (HP) (yield gpm) Deisel (type power)
(7) electric log No (yes or no) None (organization running log)
(8) how well bottom plugged steel plug

DRILLERS REMARKS:


description of formations encountered

from

to

Top soil	0	5
Brown clay	5	10
Brown clay	10	15
Brown clay	15	20
Brown clay	20	25
Brown clay	25	30
Blue clay	30	35
Brown clay	35	40
Brown clay & sand	40	45
Sand clay	45	50
Fine sand	50	55
Fine sand	55	60
Med. sand	60	65
Med. sand	65	70
Coarse sand-gravel-73f	70	75
Coarse sand & gravel	75	80
Coarse sand & gravel	80	85
Coarse sand & gravel	85	90
Coarse sand & gravel	90	95
Coarse sand & gravel	95	100
Coarse sand & gravel	100	105
Coarse sand & gravel	105	110
Coarse sand & gravel	110	115
Bottom hole 114		

Bottom hole 114

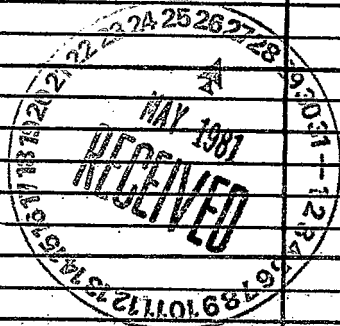

If well telescopes please
sketch and show depths.

GROUND LEVEL

SECTION _____

Please indicate well location X.

ADDITIONAL INFORMATION

If more than one screen,
show locations of each on sketch.