

SHARKEY
G 48

MISSISSIPPI
BOARD OF WATER COMMISSIONERS
416 North State Street
Jackson, Mississippi 39201

CODED

12-19-80

WATER WELL DRILLERS LOG

Dec. 19 1980
date well completed

E. M. "Bud" Cresswell
firm name

Sharkey
county well located

LANDOWNER:
Bill Crawford
CARY, MS.
(mailing address)

description of formations encountered	from	to
Clay	0	40
Sand - gravel	40	160
Shale	160	280
Sand	280	440
Sandy - Shale	440	600
Shale	600	860
Sand	860	940

WELL LOCATION:
sec. 19 T. 11 N R. 7 E
3 miles SW of CARY
(distance) (direction) (nearest town)

WELL PURPOSE: Home
(home, irrigation, municipal, industrial)

- WELL COMPLETION DATA:
- (1) diameter (inches) 4
 - (2) total depth (feet) 960
 - (3) static water level (feet) 18 below top of ground.
 - (4) casing Steel 940
(material) (depth)
4 If telescope see back.
(size)
 - (5) screen 20 940
(length) (depth to top)
2 STAINLESS
(size) (material)
 - (6) pump 2 30
(HP) (yield gpm)
0
(type power)
 - (7) electric log No
(yes or no)
- (organization running log)

(8) how well bottom plugged
SAND SHARP

DRILLERS REMARKS:


DEPT. OF NATURAL RESOURCES
BUREAU OF LAND & WATER RESOURCES

DEC 29 1980

RECEIVED

If well telescopes please
sketch and show depths.

GROUND LEVEL

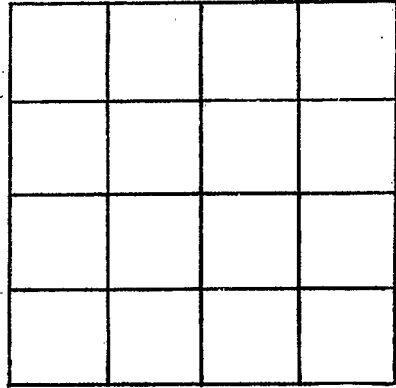

SECTION _____

Please indicate well location X.

ADDITIONAL INFORMATION

If more than one screen,
show locations of each on sketch.