

MISSISSIPPI DEPARTMENT OF NATURAL RESOURCES

Bureau of Land and Water Resources

Southport Mall

P.O. Box 10631

Jackson, Mississippi 39209

WATER WELL DRILLERS LOG

CODED

Shankley
G 49
6-19-81

June 19 1981 Larry's well & Pump Shankley
 date well completed firm name county well located

LANDOWNER: William Moore

description of formations encountered

from

to

Cary Miss
 (mailing address)

<u>Clay</u>	<u>0</u>	<u>30</u>
<u>Hard Sand</u>	<u>30</u>	<u>54</u>
<u>Coarse Sand</u>	<u>54</u>	<u>110</u>

WELL LOCATION:

sec. 34 T 11 N R. 7 E
2 miles E of Blanton
 (distance) (direction) (nearest town)

WELL PURPOSE: private
 (home, irrigation, municipal, industrial)

CODED

WELL COMPLETION DATA:

- (1) diameter (inches) 12
- (2) total depth (feet) 110
- (3) static water level (feet) 14 below top of ground
- (4) casing Steel, 70 (material) (depth)

(size) if telescope see back.

- (5) screen 40, 70 (length) (depth to top)
- 12, Steel (size) (material)

- (6) pump _____ (HP) _____ (yield gpm)

(type power)

- (7) electric log No (yes or no)

(organization running log)


- (8) how well bottom plugged Steel Plate

DRILLERS REMARKS:

DEPT. OF NATURAL RESOURCES
 BUREAU OF LAND & WATER RESOURCES
 JUN-16 1981
 RECEIVED

If well telescopes please sketch and show depths.

GROUND LEVEL

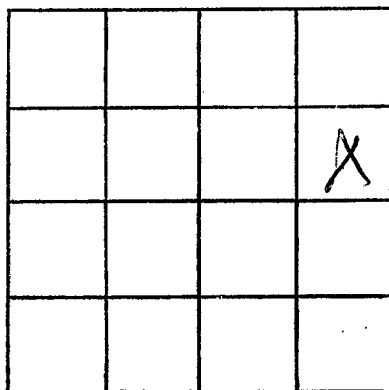

SECTION 34

Please indicate well location X.

ADDITIONAL INFORMATION

If more than one screen, show locations of each on sketch.