

MISSISSIPPI DEPARTMENT OF NATURAL RESOURCES

Bureau of Land and Water Resources

Southport Mall

P.O. Box 10631

Jackson, Mississippi 39209

WATER WELL DRILLERS LOG

19
CODED

Sharkey
652
6-21-81
Gw 8414

June 21 1981 Larry's well & pump Sharkey
date well completed firm name county well located

| | | | |
|--------------------------------------|---------------------------------------|-------------|------------|
| 17 LANDOWNER: <u>William Moore</u> | description of formations encountered | from | to |
| | | <u>Clay</u> | <u>0</u> |
| <u>Carey Ms</u> (mailing address) | <u>Fine sand</u> | <u>26</u> | <u>50</u> |
| | <u>Med. to coarse</u> | <u>50</u> | <u>110</u> |

WELL LOCATION:
sec. 34 T 11 N R. 7 E W
2 miles E of Blanton
(distance) (direction) (nearest town)

WELL PURPOSE: Fish Pond
(home, irrigation, municipal, industrial)

WELL COMPLETION DATA:

(1) diameter (inches) 12"

(2) total depth (feet) 110'

(3) static water level (feet) 17 below above top of ground.

(4) casing Steel 70'
(material) (depth)
(size) if telescope see back.

(5) screen 40' 70'
(length) (depth to top)
12" steel
(size) (material)

(6) pump _____ (HP) _____ (yield gpm)
(type power)

(7) electric log No
(yes or no)
(organization running log)

(8) how well bottom plugged Steel Plate

CODED

DEPT. OF NATURAL RESOURCES
BUREAU OF LAND & WATER RESOURCES


JUN 16 1981

RECEIVED

DRILLERS REMARKS:

If well telescopes please sketch and show depths.

GROUND LEVEL

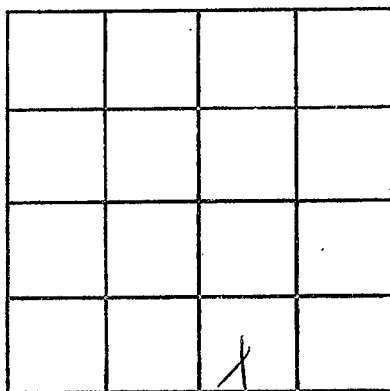

SECTION 34

Please indicate well location X.

ADDITIONAL INFORMATION

If more than one screen,
show locations of each on sketch.