

MISSISSIPPI DEPARTMENT OF NATURAL RESOURCES
Bureau of Land and Water Resources
 Southport Mall
 P.O. Box 10631
 Jackson, Mississippi 39209
WATER WELL DRILLERS LOG

CODED

Sharkey
G 57
4/23/82

4/23 1982 South Delta Irrigation Sharkey
 date well completed firm name county well located

LANDOWNER: Powers Company
Cary, ms.

description of formations encountered	from	to
<u>clay</u>	<u>0</u>	<u>30</u>
<u>fine sand</u>	<u>30</u>	<u>60</u>
<u>medium sand</u>	<u>60</u>	<u>80</u>
<u>coarse sand & gravel</u>	<u>80</u>	<u>121</u>

(mailing address)

WELL LOCATION:
 sec. 11 T. 11 N. R. 7 E.
1 miles NE of Cary
 (distance) (direction) (nearest town)

WELL PURPOSE:
 (home, irrigation, municipal, industrial)

CODED

WELL COMPLETION DATA:

- (1) diameter (inches) 16"
- (2) total depth (feet) 121'
- (3) static water level (feet) 16' below top of ground.
- (4) casing Steel, 81
 (material) (depth)
16 if telescope see back.
 (size)
- (5) screen 40, 81
 (length) (depth to top)
16, Steel
 (size) (material)
- (6) pump 60, 3000
 (HP) (yield gpm)
propane
 (type power)
- (7) electric log no
 (yes or no)
- (organization running log)
- (8) how well bottom plugged plate

DEPT. OF NATURAL RESOURCES
 BUREAU OF LAND & WATER RESOURCES


MAY 25 1982

DRILLERS REMARKS:

RECEIVED

If well telescopes please sketch and show depths.

GROUND LEVEL

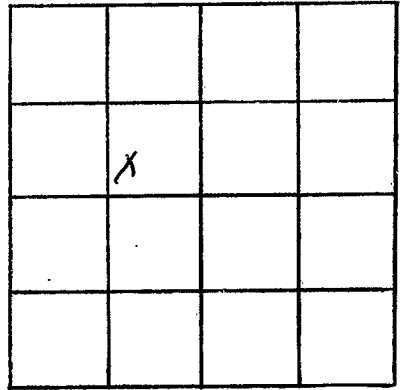

SECTION 11

Please indicate well location X.

ADDITIONAL INFORMATION

If more than one screen, show locations of each on sketch.