

MISSISSIPPI DEPARTMENT OF NATURAL RESOURCES

Bureau of Land and Water Resources

Southport Mall

P.O. Box 10631

CODED

Jackson, Mississippi 39209

WATER WELL DRILLERS LOG

SHARKEY
G 58
11/8/83

G

Nov. 8 1983 E.M. Bud Cresswell SHARKEY
 date well completed firm name county well located

| LANDOWNER: | description of formations encountered | from | to |
|--|---------------------------------------|------------|------------|
| | | | |
| <u>The Power Co.</u> | <u>Clay</u> | <u>0</u> | <u>30</u> |
| <u>CARY, MS.</u> (mailing address) | <u>sand - gravel</u> | <u>30</u> | <u>185</u> |
| | <u>Shale</u> | <u>185</u> | <u>290</u> |
| WELL LOCATION: | <u>Sand - gravel</u> | <u>290</u> | <u>625</u> |
| sec. <u>19</u> T. <u>11</u> N R. <u>7</u> W | <u>Shale</u> | <u>625</u> | <u>780</u> |
| <u>2</u> miles <u>SW</u> of <u>CARY</u> | <u>Sand</u> | <u>780</u> | <u>850</u> |
| (distance) (direction) of (nearest town) | <u>Shale - hard</u> | <u>850</u> | <u>880</u> |
| WELL PURPOSE: <u>farm</u> (home, irrigation, municipal, industrial) | <u>Sand</u> | <u>880</u> | <u>960</u> |
| WELL COMPLETION DATA: | | | |
| (1) diameter (inches) <u>4</u> | | | |
| (2) total depth (feet) <u>960</u> | | | |
| (3) static water level (feet) <u>25</u> below top of ground. | | | |
| (4) casing <u>Steel</u> , <u>920</u> (material), (depth) | | | |
| <u>4</u> (size) If telescope see back. | | | |
| (5) screen <u>40</u> , <u>920</u> (length), (depth to top) | | | |
| <u>2</u> , <u>Stainless</u> (size), (material) | | | |
| (6) pump <u>1 1/2</u> , <u>30</u> (HP), (yield gpm) | | | |
| (type power) | | | |
| (7) electric log <u>NO</u> (yes or no) | | | |
| (organization running log) | | | |
| (8) how well bottom plugged <u>Back Wash valve</u> | | | |

CODED

DEPT. OF NATURAL RESOURCES
 BUREAU OF LAND & WATER RESOURCES


NOV 23 1983

RECEIVED

DRILLERS REMARKS:

If well telescopes please sketch and show depths.

GROUND LEVEL

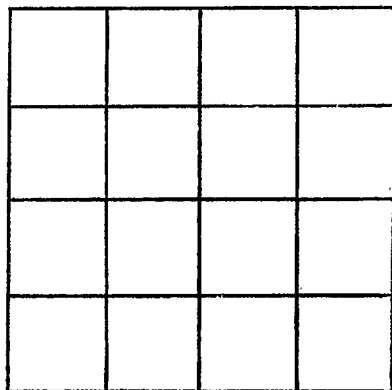

SECTION _____

Please indicate well location X.

ADDITIONAL INFORMATION

If more than one screen,
show locations of each on sketch.