

MISSISSIPPI DEPARTMENT OF NATURAL RESOURCES

Bureau of Land and Water Resources

Southport Mall

P.O. Box 10631

Jackson, Mississippi 39209

WATER WELL DRILLERS LOG

CODED

SHARKEY  
G 59

5-17-84  
date well completed

IRRIGATION EQUIPMENT  
firm name

SHARKEY  
county well located

LANDOWNER: BURT DARDEN

Rt. 2 Rolling Fork, MS

39159

(mailing address)

WELL LOCATION:

sec. 28 T. 11 (N) R. 7 (E)  
S (W)  
2 miles south of CARY  
(distance) (direction) (nearest town)

WELL PURPOSE: IRRIGATION  
(home, irrigation, municipal, industrial)

WELL COMPLETION DATA:

- (1) diameter (inches) 16"
- (2) total depth (feet) 115'
- (3) static water level (feet) 18' below above top of ground.
- (4) casing steel 75'  
(material) (depth)  
(size) if telescope see back.
- (5) screen 40' 75'  
(length) (depth to top)  
16" steel  
(size) (material)
- (6) pump \_\_\_\_\_ (HP) \_\_\_\_\_ (yield gpm)  
(type power)
- (7) electric log \_\_\_\_\_ (yes or no)  
(organization running log)
- (8) how well bottom plugged Steel PLATE

description of formations encountered

from

to

CLAY	0	40
SAND	40	50
CLAY AND SAND	50	60
FINE SAND	60	75
COARSE SAND/GRAVEL	75	115

CODED

DEPT. OF NATURAL RESOURCES  
BUREAU OF LAND & WATER RESOURCES


SEP 26 1984

RECEIVED

DRILLERS REMARKS:

If well telescopes please sketch and show depths.

GROUND LEVEL

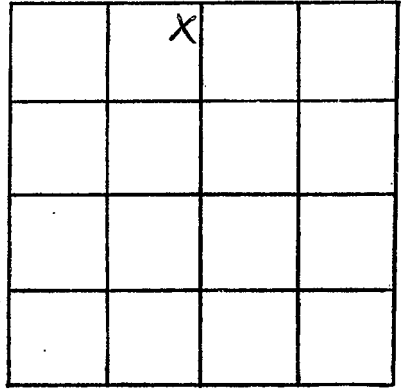

SECTION 28

Please indicate well location X.

ADDITIONAL INFORMATION

If more than one screen,  
show locations of each on sketch.