

MISSISSIPPI DEPARTMENT OF NATURAL RESOURCES
Bureau of Land and Water Resources
 Southport Mall
 P.O. Box 10631
 Jackson, Mississippi 39209
WATER WELL DRILLERS LOG

G 60
Sharkey

3-25-85 19 IRrigation Equipment Sharkey
 date well completed firm name county well located

LANDOWNER: MOORE Planting Co.
 Hwy 61 South Cary, MS

description of formations encountered	from	to
<u>Clay</u>	<u>0</u>	<u>65</u>
<u>Coarse sand</u>	<u>65</u>	<u>110</u>
<u>Coarse sand/gravel</u>	<u>110</u>	<u>120</u>

(mailing address)
 WELL LOCATION:
 sec. 19 T. 11 N. R. 7 E.
4 miles SW of CARY
 (distance) (direction) (nearest town)

WELL PURPOSE: IRrigation
 (home, irrigation, municipal, industrial)

- WELL COMPLETION DATA:
- diameter (inches) 16"
 - total depth (feet) 120
 - static water level (feet) 12' below above top of ground.
 - casing Steel 80'
 (material) (depth)
 - if telescope see back.
 (size)
 (5) screen 40' 80'
 (length) (depth to top)
1 1/2" Steel
 (size) (material)
 - pump _____
 (HP) (yield gpm)
 (type power)
 - electric log NO
 (yes or no)
 - (organization running log)
 - how well bottom plugged steel plate

DRILLERS REMARKS:


RECEIVED
 MAY - 2 1985

Department of Natural Resources
 Bureau of Land & Water Resources

If well telescopes please sketch and show depths.

IRRIGATION EQUIPMENT
601/887-2555
INDIANOLA, MS

GROUND LEVEL

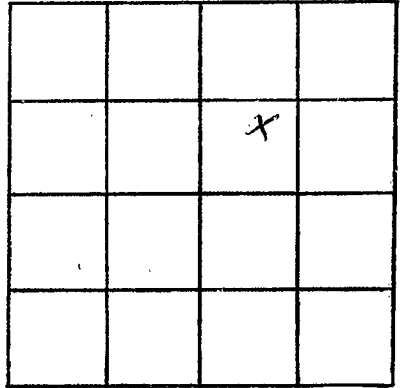

SECTION 19

Please indicate well location X.

ADDITIONAL INFORMATION

If more than one screen,
show locations of each on sketch.