

MISSISSIPPI DEPARTMENT OF NATURAL RESOURCES

Bureau of Land and Water Resources

Southport Mall

P.O. Box 10631

Jackson, Mississippi 39209

WATER WELL DRILLERS LOG

CODED

SHARKEY
G 61

6-13-85

IRRIGATION EQUIPMENT

SHARKEY

date well completed

firm name

county well located

LANDOWNER: J.K. Stewart

description of formations encountered

from

to

Box 248 CARY, MS 39054

601-873-4592

(mailing address)

CLAY	0	20
FINE SAND	20	40
COURSE SAND	40	95
COURSE SAND / PEA GRAVEL	95	115

WELL LOCATION:

sec. 8 T 11 (N) R 7 E
S (W)
2 miles N of CARY, MS
(distance) (direction) (nearest town)

WELL PURPOSE: FISH POND
(home, irrigation, municipal, industrial)


WELL COMPLETION DATA:

- (1) diameter (inches) 16"
- (2) total depth (feet) 115'
- (3) static water level (feet) 25 below above top of ground.
- (4) casing steel, 75'
(material) (depth)
- (size) if telescope see back.
- (5) screen 40', 75'
(length) (depth to top)
- 16", steel
(size) (material)
- (6) pump 60, 3000
(HP) (yield gpm)
- Electric
(type power)
- (7) electric log NO
(yes or no)

(organization running log)

(8) how well bottom plugged STEEL PLATE

DRILLERS REMARKS:

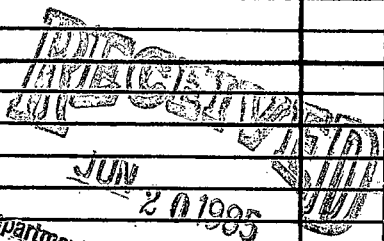

Department of Natural Resources
Bureau of Land & Water Resources

If well telescopes please sketch and show depths.

IRRIGATION EQUIPMENT
601/887-2555
INDIANOLA, MS

GROUND LEVEL

	X		

SECTION 8

Please indicate well location X.

ADDITIONAL INFORMATION

If more than one screen,
show locations of each on sketch.