

MISSISSIPPI DEPARTMENT OF NATURAL RESOURCES

Bureau of Land and Water Resources

Southport Mall

P.O. Box 10631

Jackson, Mississippi 39209

WATER WELL DRILLERS LOG CODED

G62
Sharkey
8-77-85

Aug 27 1985
date well completed

F.M. Bud Cresswell
firm name

Sharkey
county well located

LANDOWNER:
Bellgrade Lumber Co.

CARY, MS.
(mailing address)

WELL LOCATION:
sec. 16 T 11 N R 7 E
in CARY, MS.
(distance) miles (direction) of (nearest town)

WELL PURPOSE: Industrial
(home, irrigation, municipal, industrial)

WELL COMPLETION DATA:

- (1) diameter (inches) 4
- (2) total depth (feet) 790
- (3) static water level (feet) 30 below top of ground.
- (4) casing Steel, 770 (material), (depth)
4 (size) if telescope see back.
- (5) screen 20, 770 (length), (depth to top)
4, Stainless (size), (material)
- (6) pump 1 1/2, 35 (HP), (yield gpm)
- (7) electric log no (yes or no)
- (8) how well bottom plugged Back Wash Valve

description of formations encountered	from	to
Surface	0	40
Sand & gravel	40	170
Shale	170	230
Sand	230	440
Shale	440	760
Sand	760	790

RECEIVED


SEP 17 1985

DRILLERS REMARKS:

Department of Natural Resources
Bureau of Land & Water Resources

If well telescopes please sketch and show depths.

GROUND LEVEL

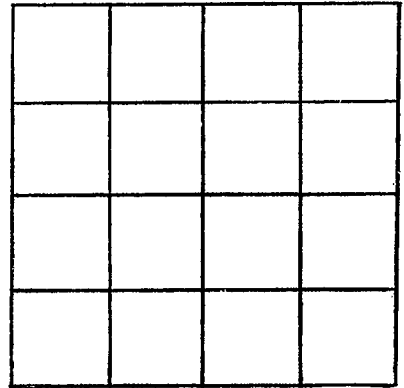

SECTION _____

Please indicate well location X.

ADDITIONAL INFORMATION

If more than one screen,
show locations of each on sketch.