

MISSISSIPPI DEPARTMENT OF NATURAL RESOURCES

Bureau of Land and Water Resources

Southport Mall

P.O. Box 10631

Jackson, Mississippi 39209

WATER WELL DRILLERS LOG

Sharkey
G 2000

Aug. 17 19*82* *E.M. "Bud" Cresswell* *Sharkey*
 date well completed firm name county well located

LANDOWNER:	description of formations encountered	from	to
<i>W. W. Moore</i> <i>Cary, Ms.</i> (mailing address)			
WELL LOCATION:	<i>Sand, gravel</i>	<i>30</i>	<i>110</i>
sec <i>34</i> T <i>11</i> N R <i>7</i> <i>2</i> miles <i>South</i> of <i>CARY</i> (distance) (direction) (nearest town)			
WELL PURPOSE: <i>Farm</i> (home, irrigation, municipal, industrial)			
WELL COMPLETION DATA:			
(1) diameter (inches) <i>4</i>			
(2) total depth (feet) <i>110</i>			
(3) static water level (feet) <i>20</i> below above top of ground.			
(4) casing <i>PVC</i> <i>70</i> (material) (depth) <i>4</i> If telescope see back. (size)			
(5) screen <i>40</i> <i>70</i> (length) (depth to top) <i>4</i> <i>PVC</i> (size) (material)			
(6) pump <i>1</i> <i>25</i> (HP) (yield gpm) (type power)			
(7) electric log <i>No</i> (yes or no) (organization running log)			
(8) how well bottom plugged <i>dark wash & blue</i>			
DRILLERS REMARKS:			


DEPT. OF NATURAL RESOURCES
 BUREAU OF LAND & WATER RESOURCES

AUG 31 1982

RECEIVED

If well telescopes please sketch and show depths.

GROUND LEVEL

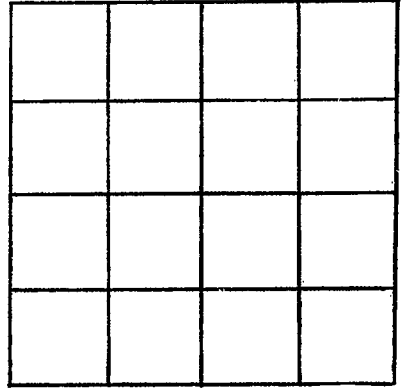

SECTION _____

Please indicate well location X.

ADDITIONAL INFORMATION

If more than one screen,
show locations of each on sketch.