

MISSISSIPPI DEPARTMENT OF NATURAL RESOURCES

Bureau of Land and Water Resources

COUNTY WELL LOCATED
Scharkey

WELL NUMBER CODED
G 205

DATE WELL COMPLETED
3-27-92

PERMIT NUMBER
186A

NAME OF DRILLING FIRM
Larry's Well & pump

P.O. Box 10631
Jackson, Mississippi 39209
WATER WELL DRILLERS LOG

NAME & MAILING ADDRESS OF LANDOWNER
Charles Weissinger
P.O. 306
Rolling Fork ms 3919

WELL LOCATION: SEC 3 TOWNSHIP 11 N S RANGE 7 E W

DISTANCE 2 Miles DIRECTION North of NEAREST TOWN Carly

OTHER LANDMARK _____

WELL PURPOSE: Home Irrigation Municipal, Industrial, Fish Pond, etc.

PUMP DATA

PUMP TYPE (Circle One): Submersible, Turbine, Jet, Flowing Well, Other (Describe) _____

POWER TYPE (Circle One): Electric, Tractor, Diesel, Gasoline, Butane, Other (Describe) _____

Pump Capacity (GPM)	No. of Stages	Setting Depth
		FT.

PUMP TEST

Well yielded _____ GPM with a drawdown of _____ ft. after _____ hours of pumping

WELL DATA

Well Depth <u>124'</u>	Casing Diameter (In.) <u>16"</u>	Casing Length (Ft.) <u>84'</u>
Type of Casing <u>Steel</u>	Hole Depth <u>124'</u>	Depth to Static Water Level <u>10'</u>

TYPE OF COMPLETION: (Circle One or More): Gravel Packed, Underreamed, Telescoped, Natural Development, Open Hole, Other (Describe) _____

Top of Lap Pipe or Reduction in Casing

FEET	IF TELESCOPED OR MORE THAN ONE SCREEN: USE BACK PAGE
------	--

LOG DATA

TYPE OF LOG RUN (Circle One): No Log Run, Electric, Gamma Ray, Density, Sonic, Neutron, Other (Describe) _____

Name of Organization Running Log _____

SCREEN DATA


Diameter - Inches <u>16"</u>	Length - Feet <u>40'</u>	Slot Size - Inches <u>.30</u>
Screen Type <u>Steel</u>	Depth to Bottom - Feet <u>124'</u>	

GEOLOGIC DATA (Office Use Only)

Surface Elev.	Geologic Unit	Unit Thickness	Depth to Top
Subs. SWL	Date	Analysis	Aquifer Test

Driller's Remarks

DESCRIPTION OF FORMATIONS ENCOUNTERED	FROM	TO	FORMATIONS (Continued)	
			FROM	TO
<u>clay</u>	<u>0</u>	<u>45</u>		
<u>fine sand</u>	<u>45</u>	<u>60</u>		
<u>coarse sand</u>	<u>60</u>	<u>124</u>		

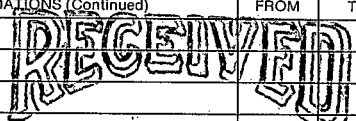

JAN 08 1993

Dept. of Environmental Quality
Bureau of Land & Water Resources

IF MORE SPACE IS NEEDED, USE BACK

If well telescopes please sketch and show depths.

GROUND LEVEL

			X

SECTION W

Please indicate well location X.

ADDITIONAL INFORMATION

If more than one screen,
show location of each on sketch.