

MISSISSIPPI DEPARTMENT OF ENVIRONMENTAL QUALITY

Office of Land and Water Resources

P. O. Box 10631
Jackson, MS 39289-0631
WATER WELL DRILLERS LOG

COUNTY WELL LOCATED Sharkey	
WELL NUMBER GA 2006	CODED
DATE WELL COMPLETED 3-11-97	

PERMIT NUMBER
NAME OF DRILLING FIRM Irrigation Equipment
Indianola, MS

NAME & MAILING ADDRESS OF LANDOWNER W.W. Moore			
Box 209			
Cary, MS 39054			
WELL LOCATION:	SEC 30	TOWNSHIP 11N	RANGE N 7W E W
DISTANCE 3	DIRECTION South	NEAREST TOWN Cary	
OTHER LANDMARK			
WELL PURPOSE: Home, Irrigation, Municipal, Industrial, Fish Pond, etc. Irrigation			

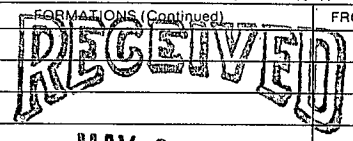
PUMP DATA		
PUMP TYPE (Circle One) Submersible, Turbine , Jet, Flowing Well, Other (Describe)		
POWER TYPE (Circle One) Electric, Tractor, Diesel , Gasoline, Butane, Other (Describe)	H/P 60	
Pump Capacity (GPM) 3000	No. of Stages 1	Setting Depth 60 FT.
PUMP TEST		
Well yielded _____ GPM with a drawdown of _____ ft. after _____ hours of pumping		

WELL DATA		
Well Depth 127	Casing Diameter (In.) 16	Casing Length (Ft.) 97
Type of Casing PVC	Hole Depth 127	Depth to Static Water Level est. 15 ft.
TYPE OF COMPLETION: (Circle One or More): Gravel Packed , Underreamed, Telescoped, Natural Development, Open Hole, Other (Describe)		
WELL GROUTED TO A DEPTH OF _____ FEET Type Grout (circle one): Cement, Bentonite, or Mix		

LOG DATA	
TYPE OF LOG RUN (Circle One): No Log Run, Electric, Gamma Ray, Density, Sonic, Neutron, Other (Describe)	
Name of Organization Running Log	

SCREEN DATA		
Diameter - Inches 16	Length - Feet 30	Slot Size - Inches .050
Screen Type PVC	Depth to Bottom - Feet 127	

GEOLOGIC DATA (Office Use Only)			
Surface Elev.	Geologic Unit	Unit Thickness	Depth to Top
Subs. SWL	Date	Analysis	Aquifer Test
Driller's Remarks			
Top of Lap Pipe or Reduction in Casing			
FEET IF TELESCOPED OR MORE THAN ONE SCREEN: USE BACK PAGE			

DESCRIPTION OF FORMATIONS ENCOUNTERED	FROM	TO	FORMATIONS (Continued)	FROM	TO
Clay	0	25	 MAY 05 1997 Dept. of Environmental Quality Office of Land & Water Resources		
Fine Sand	25	91			
Med. Sand & Gravel	91	127			
IF MORE SPACE IS NEEDED, USE BACK					

If well telescopes please sketch and show depths.

GROUND LEVEL

		X	

SECTION 30

Please indicate well location X.

ADDITIONAL INFORMATION

If more than one screen,
show location of each on sketch.