

SHARKEY
 2015
 11/6/78
 Log #100

MISSISSIPPI
 BOARD OF WATER COMMISSIONERS
 416 North State Street
 Jackson, Mississippi 39201

CODED

WATER WELL DRILLERS LOG

Nov. 6 1978 E.M. "Bud" Cresswell Sharkey
 date well completed firm name county well located

LANDOWNER:	description of formations encountered	from	to
W. W. Moore Cary, Ms. (mailing address)			
WELL LOCATION:	Sand - gravel	40	165
sec 28 T 11 N R 7 E 2 miles South of Cary (distance) (direction) (nearest town)	Sand - OTRs shale	165	770
WELL PURPOSE: none (home, irrigation, municipal, industrial)	Shale	440	850
WELL COMPLETION DATA:	Sand	850	940
(1) diameter (inches) 4			
(2) total depth (feet) 940			
(3) static water level (feet) 15 below top of ground.			
(4) casing steel 880 (material) (depth)			
2 (size) if telescope see back.			
(5) screen 40 880 (length) (depth to top)			
2 stainless (material)			
(6) pump 3 50 (HP) (yield gpm)			
0 (type power)			
(7) electric log yes (yes or no)			
State (organization running log)			
(8) how well bottom plugged Pneum plug			
DRILLERS REMARKS:			


CODED

RECEIVED
 DEC - 5 1978

MISS. BD. OF WATER COMMISSIONERS

If well telescopes please sketch and show depths.

GROUND LEVEL

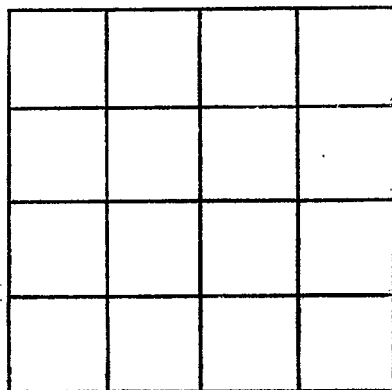

SECTION _____

Please indicate well location X.

ADDITIONAL INFORMATION

If more than one screen, show locations of each on sketch.