

Sharkey
H 5
7-13-68

MISSISSIPPI
BOARD OF WATER COMMISSIONERS
416 North State Street
Jackson, Mississippi 39201
WATER WELL DRILLERS LOG

CODED

08/18/68
JW
2643
Well # 2
CODED

July 13, 1968 Layne-Central Company Sharkey
date well completed firm name county well located

LANDOWNER: Joe Priddy & Sons

description of formations encountered

from to

Rolling Fork, Mississippi
(mailing address)

Clay	0	38
Fine sand	38	49
Coarse sand, pea gravel	49	80
Coarse sand, gravel	80	112
Fine white sand	112	


WELL LOCATION:

sec. 29 T. 11 N R. 6 E
W
4 miles southeast Cary
(distance) (direction) (nearest town)

WELL PURPOSE: irrigation
(home, irrigation, municipal, industrial)

WELL COMPLETION DATA:

- (1) diameter (inches) 16
- (2) total depth (feet) 112
- (3) static water level (feet) 8' ~~below~~ above top of ground.
- (4) casing steel, 62' (material), (depth), 16" (size) if telescope see back.
- (5) screen 50' (length), 112' (depth to top), 16" (size), Armco (material)
- (6) pump 60 (HP), 2500 (yield gpm), electric (type power)
- (7) electric log no (yes or no), (organization running log)
- (8) how well bottom plugged plate

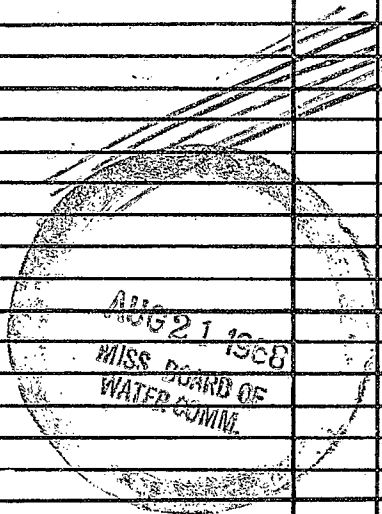

DRILLERS REMARKS:

If well telescopes please sketch and show depths.

GROUND LEVEL

SECTION _____

Please indicate well location X.

ADDITIONAL INFORMATION

If more than one screen,
show locations of each on sketch.