


Sharkey
H.G.
7-15-68

MISSISSIPPI
 BOARD OF WATER COMMISSIONERS
 416 North State Street
 Jackson, Mississippi 39201
 WATER WELL DRILLERS LOG

CODED
 8/8/68
 CODED
 2643
 Well # 3

July 15, 1968 Layne-Central Company Sharkey
 date well completed firm name county well located


LANDOWNER: Joe Priddy & Sons	description of formations encountered	from	to
Rolling Fork, Mississippi	Fine sand	36	47
(mailing address)	Coarse sand, pea gravel	47	78
WELL LOCATION:	Coarse sand, gravel	78	112
sec. <u>29</u> T. <u>11</u> N. R. <u>6</u> E	Fine white sand	112	
6 miles SE of Cary			
(distance) (direction) (nearest town)			
WELL PURPOSE: irrigation			
(home, irrigation, municipal, industrial)			
WELL COMPLETION DATA:			
(1) diameter (inches) <u>16</u>			
(2) total depth (feet) <u>112</u>			
(3) static water level (feet) <u>7'2"</u> below above top of ground.			
(4) casing <u>steel</u> , <u>62'</u>			
(material) (depth)			
<u>16"</u> if telescope see back.			
(size)			
(5) screen <u>50'</u> , <u>112'</u>			
(length) (depth to top)			
<u>16"</u> , <u>Armco</u>			
(size) (material)			
(6) pump <u>60</u> <u>2500</u>			
(HP) (yield gpm)			
<u>electric</u>			
(type power)			
(7) electric log <u>no</u>			
(yes or no)			
<u></u>			
(organization running log)			
(8) how well bottom plugged <u>plate</u>			

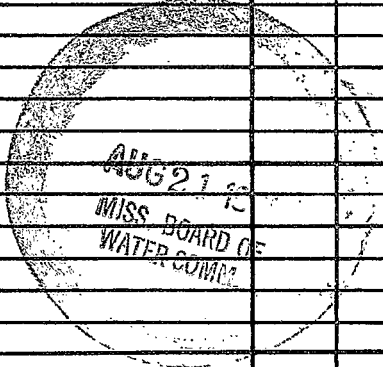

DRILLERS REMARKS:

If well telescopes please
sketch and show depths.

GROUND LEVEL

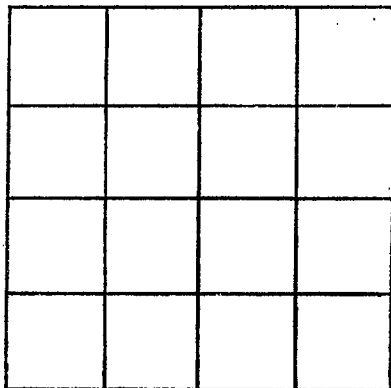

SECTION _____

Please indicate well location X.

ADDITIONAL INFORMATION

If more than one screen,
show locations of each on sketch.