

ELOG #69

SHARKEY
H7
70
21171

MISSISSIPPI
BOARD OF WATER COMMISSIONERS
416 North State Street
Jackson, Mississippi 39201

CODED

WATER WELL DRILLERS LOG

Mr. Connell Drilling Sharkey
firm name county well located

19
date well completed

LANDOWNER: U.S. Forest Ser
Rolling Fork
Hackson, Miss
(mailing address)

description of formations encountered	from	to
Clay	0	64
Gravel Sand (Small Gravel)	64	162
Clay (Sandy)	162	220
Sand	220	310
Rock (Lime)	310	311
Sand	311	420
Sand & Rock (shells)	420	450
Shale	450	748
Sand (Lignite streaks)	748	788
Shale	788	820
Sandy shale	820	856
Shale	856	930
Sandy shale	930	994
Rock (Lime)	994	1002
Shale & Rock	1002	1016
Sand	1016	1034
Rock (Lime)	1034	1042
Sand (Hrs. to Med.)	1042	1100
Sand & Shale w/ shale	1100	1119

WELL LOCATION:
sec. 11 T. 11 N. R. 6 W.
6 miles W of Holly Bluff
(distance) (direction) (nearest town)

WELL PURPOSE: Industrial
(home, irrigation, municipal, industrial)

WELL COMPLETION DATA:

- (1) diameter (inches) 4"
- (2) total depth (feet) 1119'
- (3) static water level (feet) 2 below above top of ground.
- (4) casing Steel 1063'
(material) (depth)
4" if telescope see back.
(size)
- (5) screen 20 1063'
(length) (depth to top)
4" Stainless Steel
(size) (material)
- (6) pump 3/4 21.8
(HP) (yield gpm)
Elect.
(type power)
- (7) electric log Yes
(yes or no)
USGS.
(organization running log)

CODED

FEB 1 1971


(8) how well bottom plugged
Spring & Roll

DRILLERS REMARKS:

MISS. DIV. OF
WATER CONTROL

If well telescopes please sketch and show depths.

GROUND LEVEL

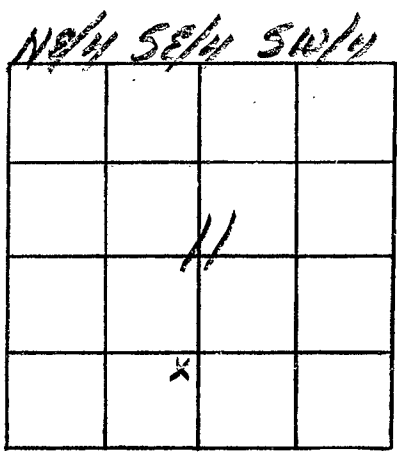


SECTION 11

Please indicate well location X.

ADDITIONAL INFORMATION

4" Johnson Telescope #18

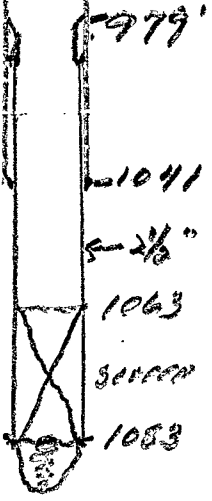

If more than one screen, show locations of each on sketch.