

H 9
1-5-65

WATER WELL DRILLERS LOG

CODED

Date: 1-5, 1965, Driller: Creech and Creswell County SHARKEY

(Name)

J. L. McANERSON

(1) Owner of Land: J. L. McANERSON
(Name)

Cary Miss
(Address) 20,30

(2) Location: 1/4, 1/4, Sec. 19 T. 11 R. 10

5 miles EAST of CARY
(distance) (direction) (Nearest Town)

(3) Topography: LEVEL
(Hilly) (Flat) (Level)

(4) Purpose of Well: DOMESTIC
(Domestic Irrigation
Municipal, Industrial, Other)

Description & Color of Materials Sand, Clay, Red Clay, Shell, etc.	Thick- ness Feet	Depth Feet
<u>Gumbo</u>	<u>60</u>	<u>60</u>
<u>SAND AND GRAVEL</u>	<u>100</u>	<u>160</u>
<u>SAND-STKS SHALE</u>	<u>220</u>	<u>380</u>
<u>SHALE-SBY-STKS</u>	<u>200</u>	<u>580</u>
<u>SHALE-Gummy</u>	<u>90</u>	<u>670</u>
<u>SAND-BOOD</u>	<u>70</u>	<u>740</u>
<u>CORRASE</u>		

Information upon completion of well:

- (1) Diameter 2 inches.
- (2) Total Depth 740 feet.
- (3) Water Level 8 + feet below top of ground.
- (4) Cased to 210, Size 4"
- (5) Screen: Size 2", Length 30'
- (6) Were any formations sealed against pollution?


 yes, no.

If YES depth of formation

Why

Drillers Remarks:

CODED

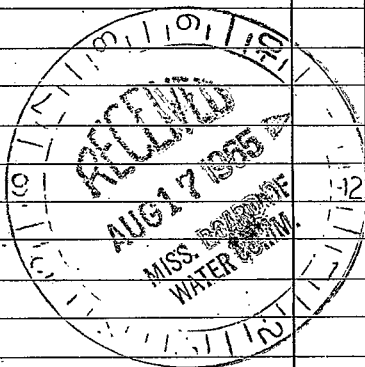

(Use Back Side)

Well No.

