

SHARKEY
H 12
1-28-72

MISSISSIPPI
 BOARD OF WATER COMMISSIONERS
 416 North State Street
 Jackson, Mississippi 39201

FEB 25 1972
CODED

WATER WELL DRILLERS LOG

Jan. 28 1972 date well completed
 E.M. "Bud" Crosswell firm name
 SHARKEY county well located

LANDOWNER:
 F.H. Coghlin
 Holly Bluff, Miss.
 (mailing address)

description of formations encountered	depth	
	from	to
Clay	0	10
Bank - gravel	10	89

WELL LOCATION:
 sec. 27 T. 4 N. R. 5
 4 miles South of Holly Bluff
 (distance) (direction) (nearest town)

WELL PURPOSE: FARM
 (home, irrigation, municipal, industrial)


- WELL COMPLETION DATA:
- (1) diameter (inches) 2
 - (2) total depth (feet) 89
 - (3) static water level (feet) 16 below top of ground.
 - (4) casing steel, 84
 (material) (depth)
2 If telescope see back.
 (size)
 - (5) screen 5 84
 (length) (depth to top)
2 STAINLESS
 (size) (material)
 - (6) pump none
 (HP) (yield gpm)
0
 (type power)
 - (7) electric log No
 (yes or no)
0
 (organization running log)
 - (8) how well bottom plugged
Deep spring

CODED

DRILLERS REMARKS:

If well telescopes please sketch and show depths.

GROUND LEVEL

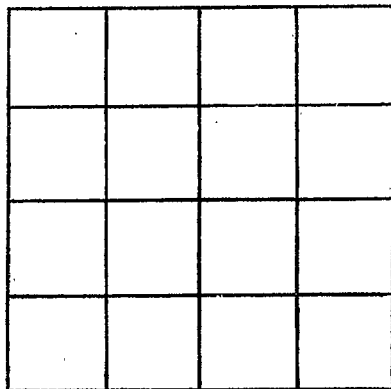

SECTION _____

Please indicate well location X.

ADDITIONAL INFORMATION

If more than one screen,
show locations of each on sketch.