

**SHARKEY**  
**H16**  
**11-30-74**  
**E log #81**  
**11-30-74** 19

**MISSISSIPPI**  
**BOARD OF WATER COMMISSIONERS**  
 416 North State Street  
 Jackson, Mississippi 39201

**WATER WELL DRILLERS LOG**

**CODED**

**14 Jefferson Drilling Co**  
 firm name


**Sharkey**  
 county well located

LANDOWNER:	description of formations encountered	from	to
<u>Mr. James Shannon</u>	<u>Sand</u>	<u>0</u>	<u>34</u>
<u>Holly Bluff, MS.</u> (mailing address)	<u>Sand</u>	<u>34</u>	<u>95</u>
<b>WELL LOCATION:</b>	<u>Sand</u> <b>CODED</b>	<u>95</u>	<u>126</u>
sec. <u>10</u> T. <u>11</u> N. R. <u>5</u> W.	<u>Sand</u>	<u>126</u>	<u>583</u>
<u>1</u> miles <u>South</u> of <u>Holly Bluff</u> (distance) (direction) (nearest town)	<u>Sand w/ shale lvs</u>	<u>583</u>	<u>644</u>
<b>WELL PURPOSE:</b> <u>home</u> (home, irrigation, municipal, industrial)	<u>Sand</u>	<u>644</u>	<u>675</u>
<b>WELL COMPLETION DATA:</b>	<u>Sand with shale lvs</u>	<u>675</u>	<u>705</u>
(1) diameter (inches) <u>4 1/2</u>	<u>Sand w/ shale lvs</u>	<u>705</u>	<u>736</u>
(2) total depth (feet) <u>1322</u>	<u>Rock</u>	<u>736</u>	<u>766</u>
(3) static water level (feet) <u>8</u> below top of ground.	<u>Sand</u>	<u>766</u>	<u>797</u>
(4) casing <u>black steel</u> , <u>150</u> , (material) (depth) <u>4" X 2</u> if telescope see back. (size)	<u>Sand with shale</u>	<u>797</u>	<u>827</u>
(5) screen <u>40ft</u> , <u>1277</u> (length) (depth to top) <u>2"</u> , <u>Stainless Steel</u> (size) (material)	<u>Shale w/ Rock</u>	<u>827</u>	<u>858</u>
(6) pump <u>2</u> (HP) <u>40</u> (yield gpm) <u>Electric</u> (type power)	<u>Sand with Rock</u>	<u>858</u>	<u>888</u>
(7) electric log <u>yes</u> (yes or no) <u>Miss Geog. Survey</u> (organization running log)	<u>Block</u>	<u>888</u>	<u>919</u>
(8) how well bottom plugged <u>Steel</u> <u>pin</u>	<u>Sand</u>	<u>919</u>	<u>949</u>
<b>DRILLERS REMARKS:</b>	<u>Sand w/ shale</u>	<u>949</u>	<u>970</u>
	<u>Sand w/ shale</u>	<u>970</u>	<u>1061</u>
	<u>Shale</u>	<u>1061</u>	<u>1092</u>
	<u>Sand</u>	<u>1092</u>	<u>1122</u>
	<u>Sand w/ sand</u>	<u>1122</u>	<u>1153</u>
	<u>Sand</u>	<u>1153</u>	<u>1183</u>
	<u>Rock</u>	<u>1183</u>	<u>1214</u>
	<u>Good Sand</u>	<u>1214</u>	<u>1265</u>
		<u>1265</u>	<u>1322</u>

**RECEIVED**  
**FEB 11 1975**  
 MISS. BD. OF WATER COMMISSIONERS

If well telescopes please sketch and show depths.

GROUND LEVEL

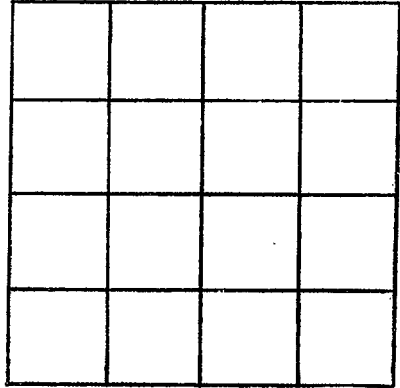

SECTION \_\_\_\_\_

Please indicate well location X.

ADDITIONAL INFORMATION

1277  
90

1311

A series of horizontal lines for recording additional information, starting below the 'ADDITIONAL INFORMATION' header and extending to the bottom of the page.

If more than one screen, show locations of each on sketch.