

Sharkey
H 17
1-67

MISSISSIPPI
BOARD OF WATER COMMISSIONERS
416 North State Street
Jackson, Mississippi 39201
WATER WELL DRILLERS LOG

CODED

1-17 19 67 Rolling Fork Machine Shop Sharkey
date well completed firm name county well located

LANDOWNER: Joe Carson

description of formations encountered

from to

Holly Bluff, Miss.
(mailing address)

Sandy Loam	0	10
Blue Clay	10	67
Fine Sand	67	72
Sand & Gravel	72	87

WELL LOCATION:

sec 32 T 11 N R 5 E
S S Spanish Fork
0 miles of (direction) (nearest town)


WELL PURPOSE: home
(home, irrigation, municipal, industrial)

CODED

WELL COMPLETION DATA:

- (1) diameter (inches) 2"
- (2) total depth (feet) 87'
- (3) static water level (feet) 15' below top of ground.
- (4) casing G. Pipe 84' (material), (depth), (size) if telescope see back.
- (5) screen 36" 84' (length), (depth to top) 2" Monel Screen (size), (material)
- (6) pump 1/4 5 (HP), (yield gpm) Elec (type power)
- (7) electric log No (yes or no) (organization running log)
- (8) how well bottom plugged Check Valve

DRILLERS REMARKS:

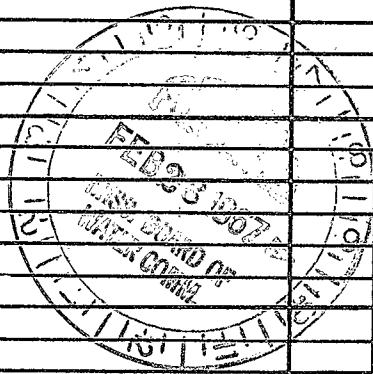

If well telescopes please sketch and show depths.

GROUND LEVEL

			X

SECTION 32

Please indicate well location X.

ADDITIONAL INFORMATION

If more than one screen, show locations of each on sketch.