

Sharkey
H 18
3-67

MISSISSIPPI
BOARD OF WATER COMMISSIONERS
416 North State Street
Jackson, Mississippi 39201

CODED

WATER WELL DRILLERS LOG

3-10-67 19 Rolling Fork Machine Shop Sharkey
date well completed firm name county well located

LANDOWNER:
Joe Carson
Holly Bluff, Miss.
(mailing address)

WELL LOCATION:
sec. 32 T. 11 N. R. 5 E.
0 miles of Spanish Fort
(distance) (direction) (nearest town)

description of formations encountered	from	to
Sandy Loam	0	15
Blue Clay	15	78
Fine Sand	78	96
Sand & Gravel	96	108

WELL PURPOSE: Home
(home, irrigation, municipal, industrial)

WELL COMPLETION DATA:

(1) diameter (inches) 2"

(2) total depth (feet) 108'

(3) static water level (feet) 16' below top of ground.

(4) casing G. Pipe 105' (material), (depth), 2" (size) if telescope see back.

(5) screen 3' 105' (length), (depth to top) 2" Monel (size), (material)

(6) pump 1/4 4 1/2 (HP), (yield gpm)


Electric (type power)

(7) electric log No (yes or no)

(organization running log)

(8) how well bottom plugged Check Valve


CODED

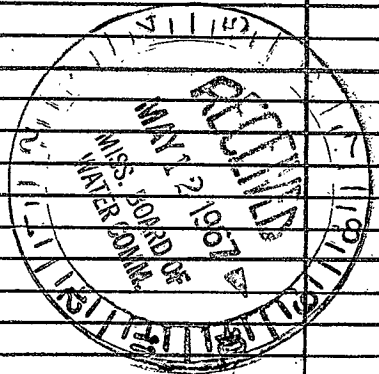

DRILLERS REMARKS:

If well telescopes please sketch and show depths.

GROUND LEVEL

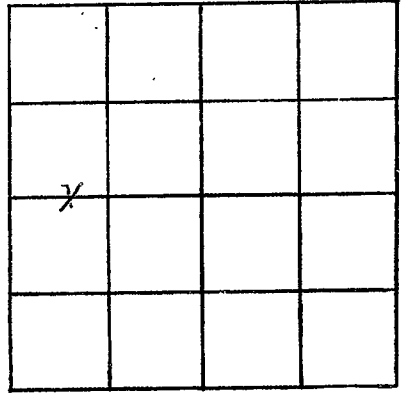

SECTION 32

Please indicate well location X.

ADDITIONAL INFORMATION

If more than one screen,
show locations of each on sketch.