

MISSISSIPPI DEPARTMENT OF NATURAL RESOURCES

Bureau of Land and Water Resources

Southport Mall

P.O. Box 10631

Jackson, Mississippi 39209

CODED

WATER WELL DRILLERS LOG

John Patton Chess
Irrigation Equipment, Inc.

SHARKEY
Sunflower

Sharkey
H 23
4/16/82
GW 8310

Li #
0.439

April 16, 1982
date well completed

DBA Jewell Copehat
firm name

county well located

LANDOWNER: *Charles Huff*

description of formations encountered

from

to

Clay	0	26'
Fine sand & clay	26'	35'
Fine Sand	35'	52'
Coarse Sand	52'	64'
Coarse sand/small gravel	64'	108'

(mailing address)

WELL LOCATION:

27 sec. *34* T. *11* N. R. *5* E. *W*
S. E. W.
2 miles North Spanish Ft.
(distance) (direction) of (nearest town)

WELL PURPOSE: *irrigation*
(home, irrigation, municipal, industrial)

WELL COMPLETION DATA:

- (1) diameter (inches) *10"*
- (2) total depth (feet) *108'*
- (3) static water level (feet) *28'* below above top of ground.
- (4) casing *steel* *68'*
(material) (depth)

_____ if telescope see back.
(size)
- (5) screen *40'* *68'*
(length) (depth to top)

10" *steel*
(size) (material)
- (6) pump *20* *900*
(HP) (yield gpm)

10 kwel
(type power)
- (7) electric log _____
(yes or no)

(organization running log)


(8) how well bottom plugged *steel plate*

DRILLERS REMARKS:

MISSISSIPPI DEPARTMENT OF NATURAL RESOURCES
BUREAU OF LAND AND WATER RESOURCES
MAY - 6 1982
RECEIVED

If well telescopes please sketch and show depths.

GROUND LEVEL

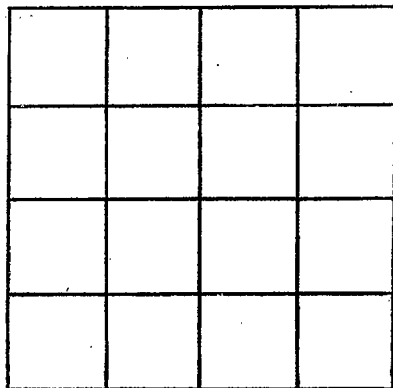

SECTION _____

Please indicate well location X.

ADDITIONAL INFORMATION

If more than one screen,
show locations of each on sketch.