

SHARKEY
 H 2000
 4-1-77

MISSISSIPPI
 BOARD OF WATER COMMISSIONERS
 416 North State Street
 Jackson, Mississippi 39201

WATER WELL DRILLERS LOG

April 1 1977 K. M. "Bud" Cresswell Sharkey
 date well completed firm name county well located

LANDOWNER:
 Benford Adcock
 Holly Bluff, Ms.
 (mailing address)

description of formations encountered	from	to
Clay	0	40
Sand-gravel	40	105

WELL LOCATION:
 sec. 32 T 11 N R. 5 E
 at Spanish Fort
 (distance) miles (direction) of (nearest town)

WELL PURPOSE: farm
 (home, irrigation, municipal, industrial)

- WELL COMPLETION DATA:
- (1) diameter (inches) 4
 - (2) total depth (feet) 105
 - (3) static water level (feet) 10 below top of ground
 - (4) casing PVC 95 (material) (depth)
 - 4 (size) If telescope see back.
 - (5) screen 10 95 (length) (depth to top)
 - 4 PVC (size) (material)
 - (6) pump 1 30 (HP) (yield gpm)
 - 0 (type power)
 - (7) electric log No (yes or no)
 - 0 (organization running log)


(8) how well bottom plugged
 plug

DRILLERS REMARKS:

RECEIVED
 APR 16 1977

If well telescopes please sketch and show depths.

GROUND LEVEL

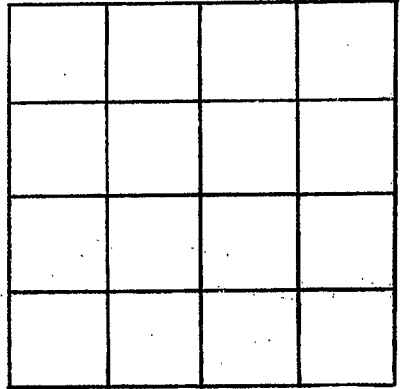

SECTION _____

Please indicate well location X.

ADDITIONAL INFORMATION

If more than one screen, show locations of each on sketch.