

SHARKEY
 H 2001
 4-1-77

MISSISSIPPI
 BOARD OF WATER COMMISSIONERS
 416 North State Street
 Jackson, Mississippi 39201

WATER WELL DRILLERS LOG

April 1 1977 ¹⁵⁴ L.M. "Bud" Crenwell Sharkey
 date well completed firm name county well located

| LANDOWNER: | description of formations encountered | from | to |
|---|---------------------------------------|------|----|
| Lenford Adcock Holly Bluff, Mo. (mailing address) | | | |

WELL LOCATION:
 sec. 32 T 11 N R. 5 E
 at Spanish Fort
 (distance) miles (direction) of (nearest town)

WELL PURPOSE: farm
 (home, irrigation, municipal, industrial)

- WELL COMPLETION DATA:
- (1) diameter (inches) 2
 - (2) total depth (feet) 105
 - (3) static water level (feet) 10 below above top of ground.
 - (4) casing PVC 100
 (material) (depth)
2 If telescope see back.
 (size)
 - (5) screen 5 100
 (length) (depth to top)
2 PVC
 (size) (material)
 - (6) pump 1 10
 (HP) (yield gpm)
0
 (type power)
 - (7) electric log No
 (yes or no)
0
 (organization running log)
 - (8) how well bottom plugged
Steel plug


DRILLERS REMARKS:

RECEIVED
 APR 12 1977

MISS. DD. OF WATER

If well telescopes please sketch and show depths.

GROUND LEVEL

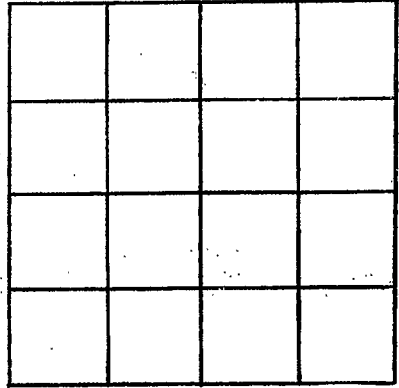

SECTION _____

Please indicate well location X.

ADDITIONAL INFORMATION

If more than one screen,
show locations of each on sketch.