

SHARKEY

H 2002

4-8-78

MISSISSIPPI BOARD OF WATER COMMISSIONERS
416 North State Street
Jackson, Mississippi 39201

WATER WELL DRILLERS LOG

4-8
date well completed

1978 K.M. "Bud" Gresswell
firm name

Sharkey
county well located

LANDOWNER:
Big Ten Camp
Holly Bluff, MS.
(mailing address)

description of formations encountered	from	to
	Clay	0
Sand & gravel	12	90

WELL LOCATION:
sec. 11 T. 11 N R. 6 E
5 miles West of Holly Bluff
(distance) (direction) (nearest town)

WELL PURPOSE: Home
(home, irrigation, municipal, industrial)

- WELL COMPLETION DATA:
- (1) diameter (inches) 2
 - (2) total depth (feet) 90
 - (3) static water level (feet) 15 below top of ground.
 - (4) casing PVC, 85
(material) (depth)
 - 2 if telescope see back.
(size)
 - (5) screen 5, 85
(length) (depth to top)
 - 2, PVC
(size) (material)
 - (6) pump 1, 10
(HP) (yield gpm)
 - 0
(type power)
 - (7) electric log No
(yes or no)
- (organization running log)

(8) how well bottom plugged
Back wash valve


DRILLERS REMARKS:

RECEIVED
MAY 3 - 1978

MISS. BD. OF WATER COMMISSIONERS

If well telescopes please sketch and show depths.

GROUND LEVEL

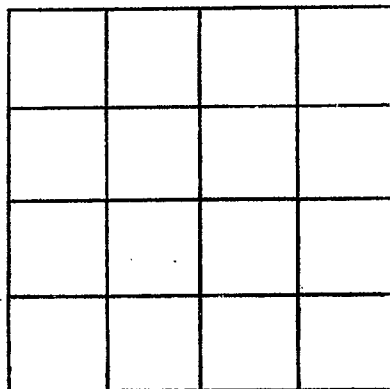

SECTION _____

Please indicate well location X.

ADDITIONAL INFORMATION

If more than one screen,
show locations of each on sketch.