

*Shackey*  
*H 2003*  
*10-15-77*

MISSISSIPPI  
 BOARD OF WATER COMMISSIONERS  
 416 North State Street  
 Jackson, Mississippi 39201

WATER WELL DRILLERS LOG

*Oct. 15* date well completed      *1977 E. M. "Bud" Cresswell* firm name      *Shackey* county well located

LANDOWNER:  
*Billy McConnell*  
*Yazoo City, MS.*  
 (mailing address)

description of formations encountered	from	to
<i>clay</i>	<i>0</i>	<i>2.5</i>
<i>sand</i>	<i>2.5</i>	<i>100</i>

WELL LOCATION:  
 sec. *28* T. *11* N. R. *15* W.  
*7* miles *EAST* of *Rolling Fork*  
 (distance) (direction) (nearest town)

WELL PURPOSE: *home*  
 (home, irrigation, municipal, industrial)

WELL COMPLETION DATA:

(1) diameter (inches) *4*

(2) total depth (feet) *100*

(3) static water level (feet) *10* below top of ground.

(4) casing *PVC*, *80*  
 (material) (depth)  
*4* if telescope see back.  
 (size)

(5) screen *20*, *80*  
 (length) (depth to top)  
*4*, *PVC*  
 (size) (material)

(6) pump *1*, *20*  
 (HP) (yield gpm)  
*0*  
 (type power)

(7) electric log *0*  
 (yes or no)  
*0*  
 (organization running log)

(8) how well bottom plugged  
*Steel plug*

DRILLERS REMARKS:


MISSISSIPPI DEPT. OF NATURAL RESOURCES  
 BUREAU OF LAND & WATER RESOURCES

NOV - 3 1977

RECEIVED

If well telescopes please sketch and show depths.

GROUND LEVEL

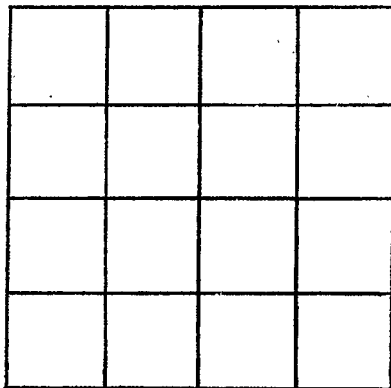

SECTION \_\_\_\_\_

Please indicate well location X.

ADDITIONAL INFORMATION

If more than one screen, show locations of each on sketch.