

MISSISSIPPI DEPARTMENT OF NATURAL RESOURCES

Bureau of Land and Water Resources

Southport Mall

P.O. Box 10631

Jackson, Mississippi 39209

WATER WELL DRILLERS LOG

SHARKEY
H 2095

Oct. 6 1988 E.M. Bud Gresswell Sharkey
date well completed firm name county well located

LANDOWNER:	description of formations encountered	from	to
JACK BRANNING	Burford Clays	0	45
Vicksburg, Ms. (mailing address)	Sand - gravel	45	140
	Shale	140	285
	Hard Shale	285	390
	Shale	390	430
	Sand	430	490
WELL LOCATION: sec. 36 T 11 N R 6 W Delta National Forest (distance) (direction) (nearest town)			
WELL PURPOSE: Camp (home, irrigation, municipal, industrial)			
WELL COMPLETION DATA:			
(1) diameter (inches) 4			
(2) total depth (feet) 490			
(3) static water level (feet) 15 below top of ground.			
(4) casing PVC, 450 (material) (depth) 4 (size) if telescope see back.			
(5) screen 40, 450 (length) (depth to top) 2 (size) PVC (material)			
(6) pump 1, 20 (HP) (yield gpm) (type power)			
(7) electric log no (yes or no) (organization running log)			
(8) how well bottom plugged Back wash Valve			

RECEIVED


NOV 2 1988

Department of Natural Resources
Bureau of Land & Water Resources

DRILLERS REMARKS:

If well telescopes please
sketch and show depths.

GROUND LEVEL

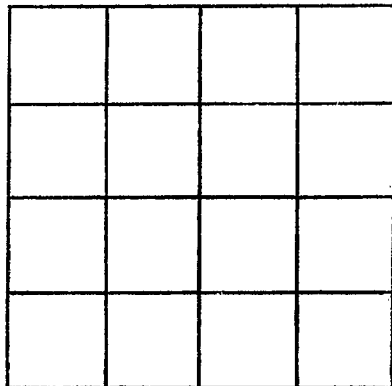

SECTION _____

Please indicate well location X.

ADDITIONAL INFORMATION

If more than one screen,
show locations of each on sketch.