

MISSISSIPPI DEPARTMENT OF NATURAL RESOURCES

Bureau of Land and Water Resources

Southport Mall

P.O. Box 10631

Jackson, Mississippi 39209

WATER WELL DRILLERS LOG

John Patton Chesin
Irrigation Equipment, Inc./Sharkey

let's see info
5/24/82

J.P.

May 5

19 82

date well completed

DBB *Jimmell Caschut Inc.* firm name

county well located

LANDOWNER: Burt Darden

description of formations encountered

from

to

Clay

0'

6'

Blue Clay

6'

35'

Fine Sand

35'

67'

Coarse sand/small rocks

67'

72'

Coarse sand & Rocks

72'

96'

Blue Clay

96'

100'

(mailing address)

WELL LOCATION:

sec. 4 T 10 N R 7 E
S W
1 miles NW of Blanton
(distance) (direction) (nearest town)

WELL PURPOSE: irrigation
(home, irrigation, municipal, industrial)

WELL COMPLETION DATA:

- (1) diameter (inches) 12"
- (2) total depth (feet) 98'
- (3) static water level (feet) 23 *below* above top of ground.
- (4) casing steel (material), (depth), (size) if telescope see back.
- (5) screen 12" Steel (length), (depth to top) (size), (material)
- (6) pump 60 (HP) 900 (yield gpm) Diesel (type power)
- (7) electric log (yes or no) (organization running log)
- (8) how well bottom plugged steel plate

DRILLERS REMARKS:


DEPT. OF NATURAL RESOURCES
BUREAU OF LAND & WATER RESOURCES

MAY 20 1982

RECEIVED

If well telescopes please
sketch and show depths.

GROUND LEVEL

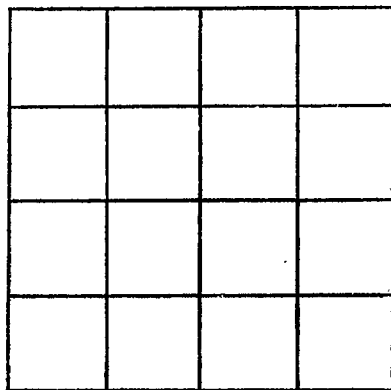

SECTION _____

Please indicate well location X.

ADDITIONAL INFORMATION

If more than one screen,
show locations of each on sketch.