

MISSISSIPPI BOARD OF WATER COMMISSIONERS

WATER WELL DRILLERS LOG CODED

Sharkey  
141  
2-1364

OK 7/29/69  
Sharkey

Date: 7/13, 1964, Driller: J. W. Ferrell, County: ~~Scott~~  
(Name)


(1) Owner of Land: L. W. Ferrell  
(Name)  
Rolling Fork, Miss  
(Address)  
5 10-7  
(2) Location: 1/4, 1/4, Sec. T R  
1 miles South of Blanton  
(distance) (direction) (Nearest Town)  
High 61  
(3) Topography: X (Hilly) X (Flat) (Level)  
(4) Purpose of Well: Home  
(Domestic Irrigation  
Municipal, Industrial, Other)

Description & Color of Materials Sand, Clay, Red Clay, Shell, etc.	Thick- ness Feet	Depth Feet
<u>Sandy Clay</u>	<u>0</u>	<u>17</u>
<u>Red clay</u>		<u>63</u>
<u>" "</u>		<u>70</u>
<u>Fine Sand</u>		<u>85</u>
<u>Black sand</u>		<u>102</u>
		<u>120</u>

Information upon completion of well:

(1) Diameter 2" inches.  
(2) Total Depth 110 feet.  
(3) Water Level 22' feet below top of ground.  
(4) Cased to 105, Size 2"  
(5) Screen: Size 2", Length 5 ft  
(6) Were any formations sealed against pollution?  
no yes, X no.

If YES depth of formation \_\_\_\_\_  
Why \_\_\_\_\_  
Drillers Remarks: \_\_\_\_\_

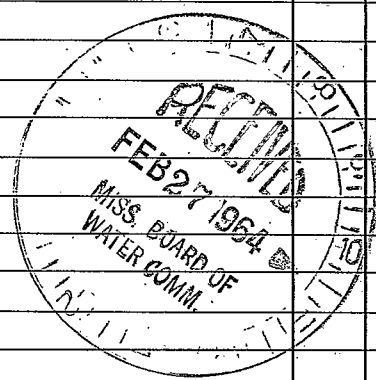

Well No.

(Use Back Side)

