

See serial 7/25/69 for

SHARKEY 15 WATER WELL DRILLERS LOG

CODED **SHARKEY**

Date: **MAY 12, 1961**, Driller: **DELTA DRILLING Co.** County: **LEFLAIRE**
 (Name)


(1) Owner of Land: **OMEGA PLANTATION**
 (Name)
ROLLING FORK MISSISSIPPI
 (Address)
25 10- 57
 (2) Location: $\frac{1}{4}$, $\frac{1}{2}$ Sec. T. R.
26
 or
 miles of
 (distance) (direction) **36** (Nearest Town)
 (3) Topography:
 (Hilly) (Flat) (Level)
 (4) Purpose of Well: **DOMESTIC**
 (Domestic Irrigation
 Municipal, Industrial, Other)

Description & Color of Materials Sand, Clay, Red Clay, Shell, etc.	Thick- ness Feet	Depth Feet
TOP SOIL + GUMBO -	42	42
SAND	43	85
GRAVEL + COARSE SAND	94	179
GUMBO	158	337
SHALE	47	384
SAND	52	436
GUMBO	18	454
SAND	14	468
GUMBO	8	476
SHALE	32	508
GUMBO w/ 1/4" ROCK -	43	551
SHALE	87	638
SAND w/ 2" ROCK -	168	806
SHALE	12	818
GUMBO	10	828
SHALE w/ 3" ROCK -	54	882
GUMBO	18	900
SHALE w/ 1/2" ROCK -	79	979
GUMBO w/ 7" ROCK	35	1014
SHALE w/ 1/2" ROCK -	28	1042
GUMBO	22	1064
SHALE	4	1069
SAND	34	1102
HARD GUMBO w/ 1/2" ROCK -	48	1151
SHALE	54	1205
GUMBO	149	1354
SHALE w/ 1/2" ROCK -	49	1403
FINE SAND	106	1509
SHALE	29	1538
SAND	47	1585
GUMBO	13	1598

Information upon completion of well:

(1) Diameter **3** inches.
 (2) Total Depth **1598** feet.
 (3) Water Level _____ feet below top of ground.
 (4) Cased to **1598**, Size **3" 220'** / **2" 1378'**
 (5) Screen: Size **2**, Length **20'**
 (6) Were any formations sealed against pollution?
 _____ yes, _____ no.

If YES depth of formation _____
 Why _____
 Drillers Remarks: **7**

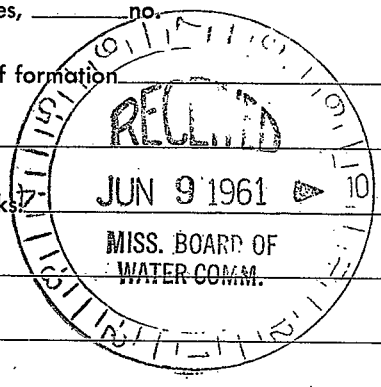

(Use Back Side)

Well No.

