

CODED

Sharkey  
8 17  
11-8-69

MISSISSIPPI  
BOARD OF WATER COMMISSIONERS  
416 North State Street  
Jackson, Mississippi 39201

11/25/69  
Sharkey  
C3046

WATER WELL DRILLERS LOG

November 8, 1969 Layne-Central Company  
date well completed firm name


Sharkey  
county well located

LANDOWNER: Joe Priddy & Sons Rolling Fork, Mississippi (mailing address)	description of formations encountered	from	to
	Clay	0	36
	Coarse sand	36	50
	Coarse sand and gravel	50	102
<b>WELL LOCATION:</b>			
sec <u>10</u> T <u>10</u> N R <u>7</u> W			
_____ miles SE of Blanton (distance) (direction) (nearest town)			
<b>WELL PURPOSE:</b> irrigation (home, irrigation, municipal, industrial)			
<b>WELL COMPLETION DATA:</b>			
(1) diameter (inches) <u>6</u>			
(2) total depth (feet) <u>102</u>			
(3) static water level (feet) <u>11'</u> below top of ground.			
(4) casing <u>steel</u> , <u>82'</u> (material) (depth)			
<u>6"</u> if telescope see back. (size)			
(5) screen <u>20'</u> , <u>102'</u> (length) (depth to top)			
<u>6"</u> Slotted pipe (size) (material)			
(6) pump <u>3</u> <u>80</u> (HP) (yield gpm)			
<u>electric</u> (type power)			
(7) electric log <u>no</u> (yes or no)			
_____ (organization running log)			
(8) how well bottom plugged <u>plate</u>			
<b>DRILLERS REMARKS:</b>			
MISS. BD. OF WATER COM.			

DEC - 4 1969

If well telescopes please  
sketch and show depths.

GROUND LEVEL

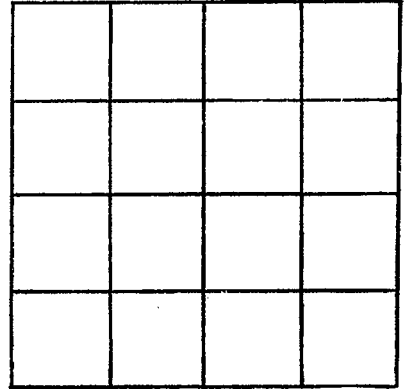

SECTION \_\_\_\_\_

Please indicate well location X.

ADDITIONAL INFORMATION

If more than one screen,  
show locations of each on sketch.