

SHARKEY  
 J 18  
 2-5-70

MISSISSIPPI  
 BOARD OF WATER COMMISSIONERS  
 416 North State Street  
 Jackson, Mississippi 39201

CODED

WATER WELL DRILLERS LOG  
 DYER WELL & IRRIGATION SERVICE

SHARKEY

2-5-70 19 date well completed      firm name      county well located

LANDOWNER:  
 Moore Planting Co.  
 Cary, Miss.  
 (mailing address)

description of formations encountered	from to	
Clay	0	43
Fine sand	43	73
med. sand	73	83
Coarse sand & gravel	83	123

WELL LOCATION:  
 sec. 3 T. 10 N. R. 7 E  
 1 1/2 miles E of Blanton  
 (distance) (direction) (nearest town)

WELL PURPOSE: END  
 (home, irrigation, municipal, industrial)

- WELL COMPLETION DATA:
- (1) diameter (inches) 16"
  - (2) total depth (feet) 123
  - (3) static water level (feet) 9 below above top of ground.
  - (4) casing Steel 83  
 (material) (depth)  
16" if telescope see back.  
 (size)
  - (5) screen 40' 83  
 (length) (depth to top)  
16" Steel  
 (size) (material)
  - (6) pump 60 3000  
 (HP) (yield gpm)  
Diesel  
 (type power)
  - (7) electric log NO  
 (yes or no)

(organization running log)

(8) how well bottom plugged plate


FFR 17 1970

DRILLERS REMARKS:

MISSISSIPPI BOARD OF WATER COMMISSIONERS

If well telescopes please sketch and show depths.

GROUND LEVEL

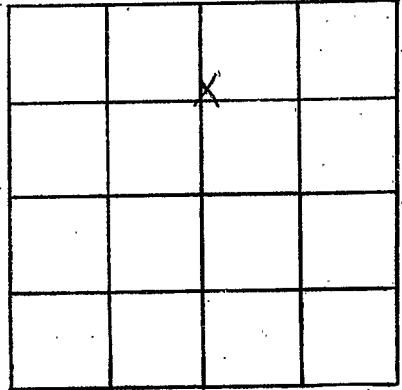

SECTION 3

Please indicate well location X.

ADDITIONAL INFORMATION

If more than one screen, show locations of each on sketch.