

Sharkey
819
6-15-70

MISSISSIPPI
BOARD OF WATER COMMISSIONERS
416 North State Street
Jackson, Mississippi 39201

CODED

ltr 9/24/70
2nd report 1/23-70

WATER WELL DRILLERS LOG

6-15 1970 ^{R.M. #} End "Cresswell" SHARKEY
date well completed firm name county well located

LANDOWNER:
Berford Adcock
Holly Bluff, Miss-
(mailing address)

description of formations encountered	from	to
<u>Clay</u>	<u>0</u>	<u>30</u>
<u>Sand</u>	<u>30</u>	<u>60</u>
<u>Sand-gravel</u>	<u>60</u>	<u>89</u>

WELL LOCATION:
sec. 5 T. 10N S R. 7 E
2 miles South of CLAYTON
(distance) (direction) (nearest town)

WELL PURPOSE: live stock
(home, irrigation, municipal, industrial)

- WELL COMPLETION DATA:
- (1) diameter (inches) 2
 - (2) total depth (feet) 89
 - (3) static water level (feet) 16 below above top of ground.
 - (4) casing Steel, 84,
(material) (depth)
2 if telescope see back.
(size)
 - (5) screen 5, 84
(length) (depth to top)
2, stainless
(size) (material)
 - (6) pump 1, 10 est.
(HP) (yield gpm)
(type power)
 - (7) electric log No
(yes or no)
0
(organization running log)

Head Location
Reed 11/30/70

CODED

(8) how well bottom plugged
Steel plug


DRILLERS REMARKS:

JUN 23 1970

MISS. BUREAU OF
WATER CONTROL

If well telescopes please
sketch and show depths.

GROUND LEVEL

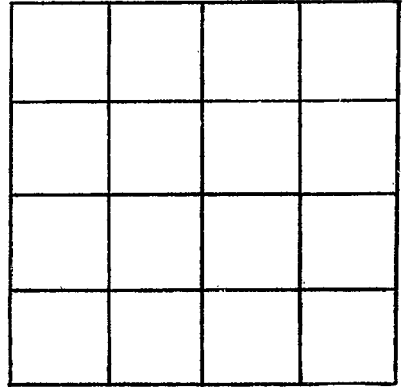

SECTION _____

Please indicate well location X.

ADDITIONAL INFORMATION

If more than one screen,
show locations of each on sketch.