

SHARKEY
J 20
4-26-71

MISSISSIPPI
 BOARD OF WATER COMMISSIONERS
 416 North State Street
 Jackson, Mississippi 39201

CODED

C3440

WATER WELL DRILLERS LOG

April 26, 19 71 SINGER-Layne Central Division Sharkey
 date well completed firm name county well located

LANDOWNER: Joe Priddy & Sons

Rolling Fork, Mississippi

(mailing address)

description of formations encountered	from	to
Clay	0	31
Sand	31	45
Coarse sand	45	84

WELL LOCATION:

sec. 9 T 10 N R. 7 XEX
 X&X W
 _____ miles SE of Blanton
 (distance) (direction) (nearest town)

WELL PURPOSE: irrigation
 (home, irrigation, municipal, industrial)

WELL COMPLETION DATA:

- (1) diameter (inches) 6"
- (2) total depth (feet) 84' 6"
- (3) static water level (feet) 10' 10" below
 top of ground. ~~above~~
- (4) casing steel, 64' 2"
 (material) (depth)
6"
 (size) if telescope see back.
- (5) screen 20' 4", 84' 6"
 (length) (depth to top)
6", steel
 (size) (material)
- (6) pump 3, 100
 (HP) (yield gpm)
electric
 (type power)
- (7) electric log no
 (yes or no)

 (organization running log)
- (8) how well bottom plugged plate

CODED


MAY 18 1971

MISS. Bd. of
 WATER COMMISSIONERS

DRILLERS REMARKS:

If well telescopes please sketch and show depths.

GROUND LEVEL

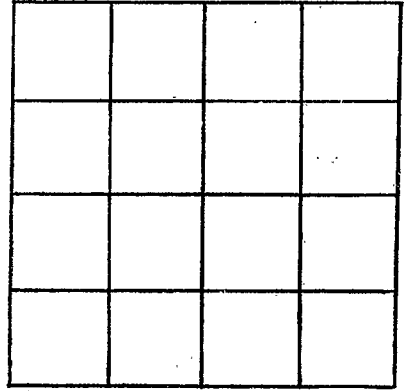

SECTION _____

Please indicate well location X.

ADDITIONAL INFORMATION

If more than one screen,
show locations of each on sketch.