

SHARKEY
JOE
4-28-71

MISSISSIPPI
 BOARD OF WATER COMMISSIONER
 416 North State Street
 Jackson, Mississippi 39201

CODED

C3440

WATER WELL DRILLERS LOG

April 28, 1971 SINGER-Layne Central Division Sharkey
 date well completed firm name county well located

| LANDOWNER: Joe Priddy & Sons | description of formations encountered | from | to |
|--|---------------------------------------|------|-----|
| Rolling Fork, Mississippi | | | |
| | Sand | 41 | 55 |
| | Coarse sand | 55 | 82 |
| (mailing address) | Coarse sand & pea gravel | 82 | 95 |
| | Coarse sand & gravel | 95 | 106 |
| WELL LOCATION: | | | |
| sec. 9 T. 10 N. R. 7 W. | | | |
| SE of Blanton | | | |
| (distance) miles (direction) of (nearest town) | | | |
| WELL PURPOSE: Irrigation | | | |
| (home, irrigation, municipal, industrial) | | | |
| WELL COMPLETION DATA: | | | |
| (1) diameter (inches) 16 | | | |
| (2) total depth (feet) 106 | | | |
| (3) static water level (feet) 10' 10" below top of ground. | | | |
| (4) casing steel 56' (material) (depth) | | | |
| 16" (size) if telescope see back. | | | |
| (5) screen 50' 106' (length) (depth to top) | | | |
| 16" (size) Armco (material) | | | |
| (6) pump 60 2500 (HP) (yield gpm) | | | |
| electric (type power) | | | |
| (7) electric log no (yes or no) | | | |
| (organization running log) | | | |
| (8) how well bottom plugged plate | | | |
| DRILLERS REMARKS: | | | |


CODED

MAY 18 1971

MISS. Bd. of WATER COMMISSIONER

If well telescopes please sketch and show depths.

GROUND LEVEL

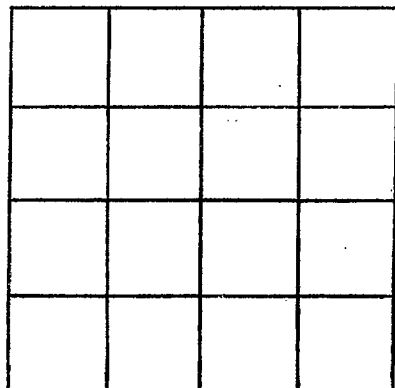

SECTION _____

Please indicate well location X.

ADDITIONAL INFORMATION

If more than one screen,
show locations of each on sketch.