

SHARKEY MISSISSIPPI BOARD OF WATER COMMISSIONERS

J 23
2-7-64

SHARKEY?

WATER WELL DRILLERS LOG

Date: 27, 1964, Driller: Frank Pily County: CODED
(Name)

(1) Owner of Land: Joseph Bidney
(Name)
Blanton, Miss
(Address)

(2) Location: 1/4, 1/4, Sec. 12 T10 R7,
3 miles East, of Blanton
(distance) (direction) (Nearest Town)

(3) Topography: X
(Hilly) (Flat) (Level)

(4) Purpose of Well: Home
(Domestic Irrigation
Municipal, Industrial, Other)

| Description & Color of Materials Sand, Clay, Red Clay, Shell, etc. | Thick- ness Feet | Depth Feet |
|---|------------------------|---------------|
| <u>Gumbo</u> | <u>0</u> | <u>16</u> |
| <u>Blue Gumbo</u> | | <u>38</u> |
| <u>Sand</u> | | <u>115</u> |
| <u>Sand + Gravel</u> | | <u>164</u> |
| <u>Clay, 5th band + 11th band</u> | | <u>259</u> |
| <u>Shale + 11th sand (fine)</u> | | <u>370</u> |
| <u>Rock</u> | | <u>410</u> |
| <u>Shale + 11th Rock</u> | | <u>437</u> |
| <u>Rock</u> | | <u>440</u> |
| <u>Shale + 11th Rock</u> | | <u>596</u> |
| <u>Shale</u> | | <u>805</u> |
| <u>Fine sand</u> | | <u>826</u> |
| <u>Hard shale</u> | | <u>907</u> |
| <u>Fine sand</u> | | <u>910</u> |
| <u>Sand</u> | | <u>930</u> |
| <u>sand + 11th shale</u> | | <u>950</u> |

Information upon completion of well:

(1) Diameter 2 inches.

(2) Total Depth 944 feet.


(3) Water Level Flowing feet below top of ground.

(4) Cased to 924, Size 2"

(5) Screen: Size 3", Length 20ft

(6) Were any formations sealed against pollution?
 _____ yes, X no.

CODED

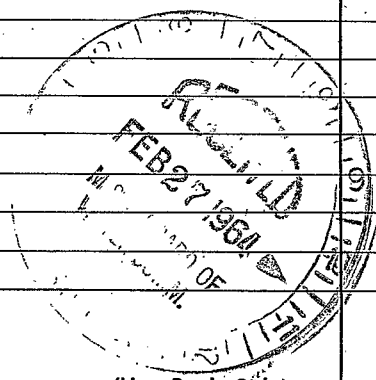

(Use Back Side)

Well No.

